


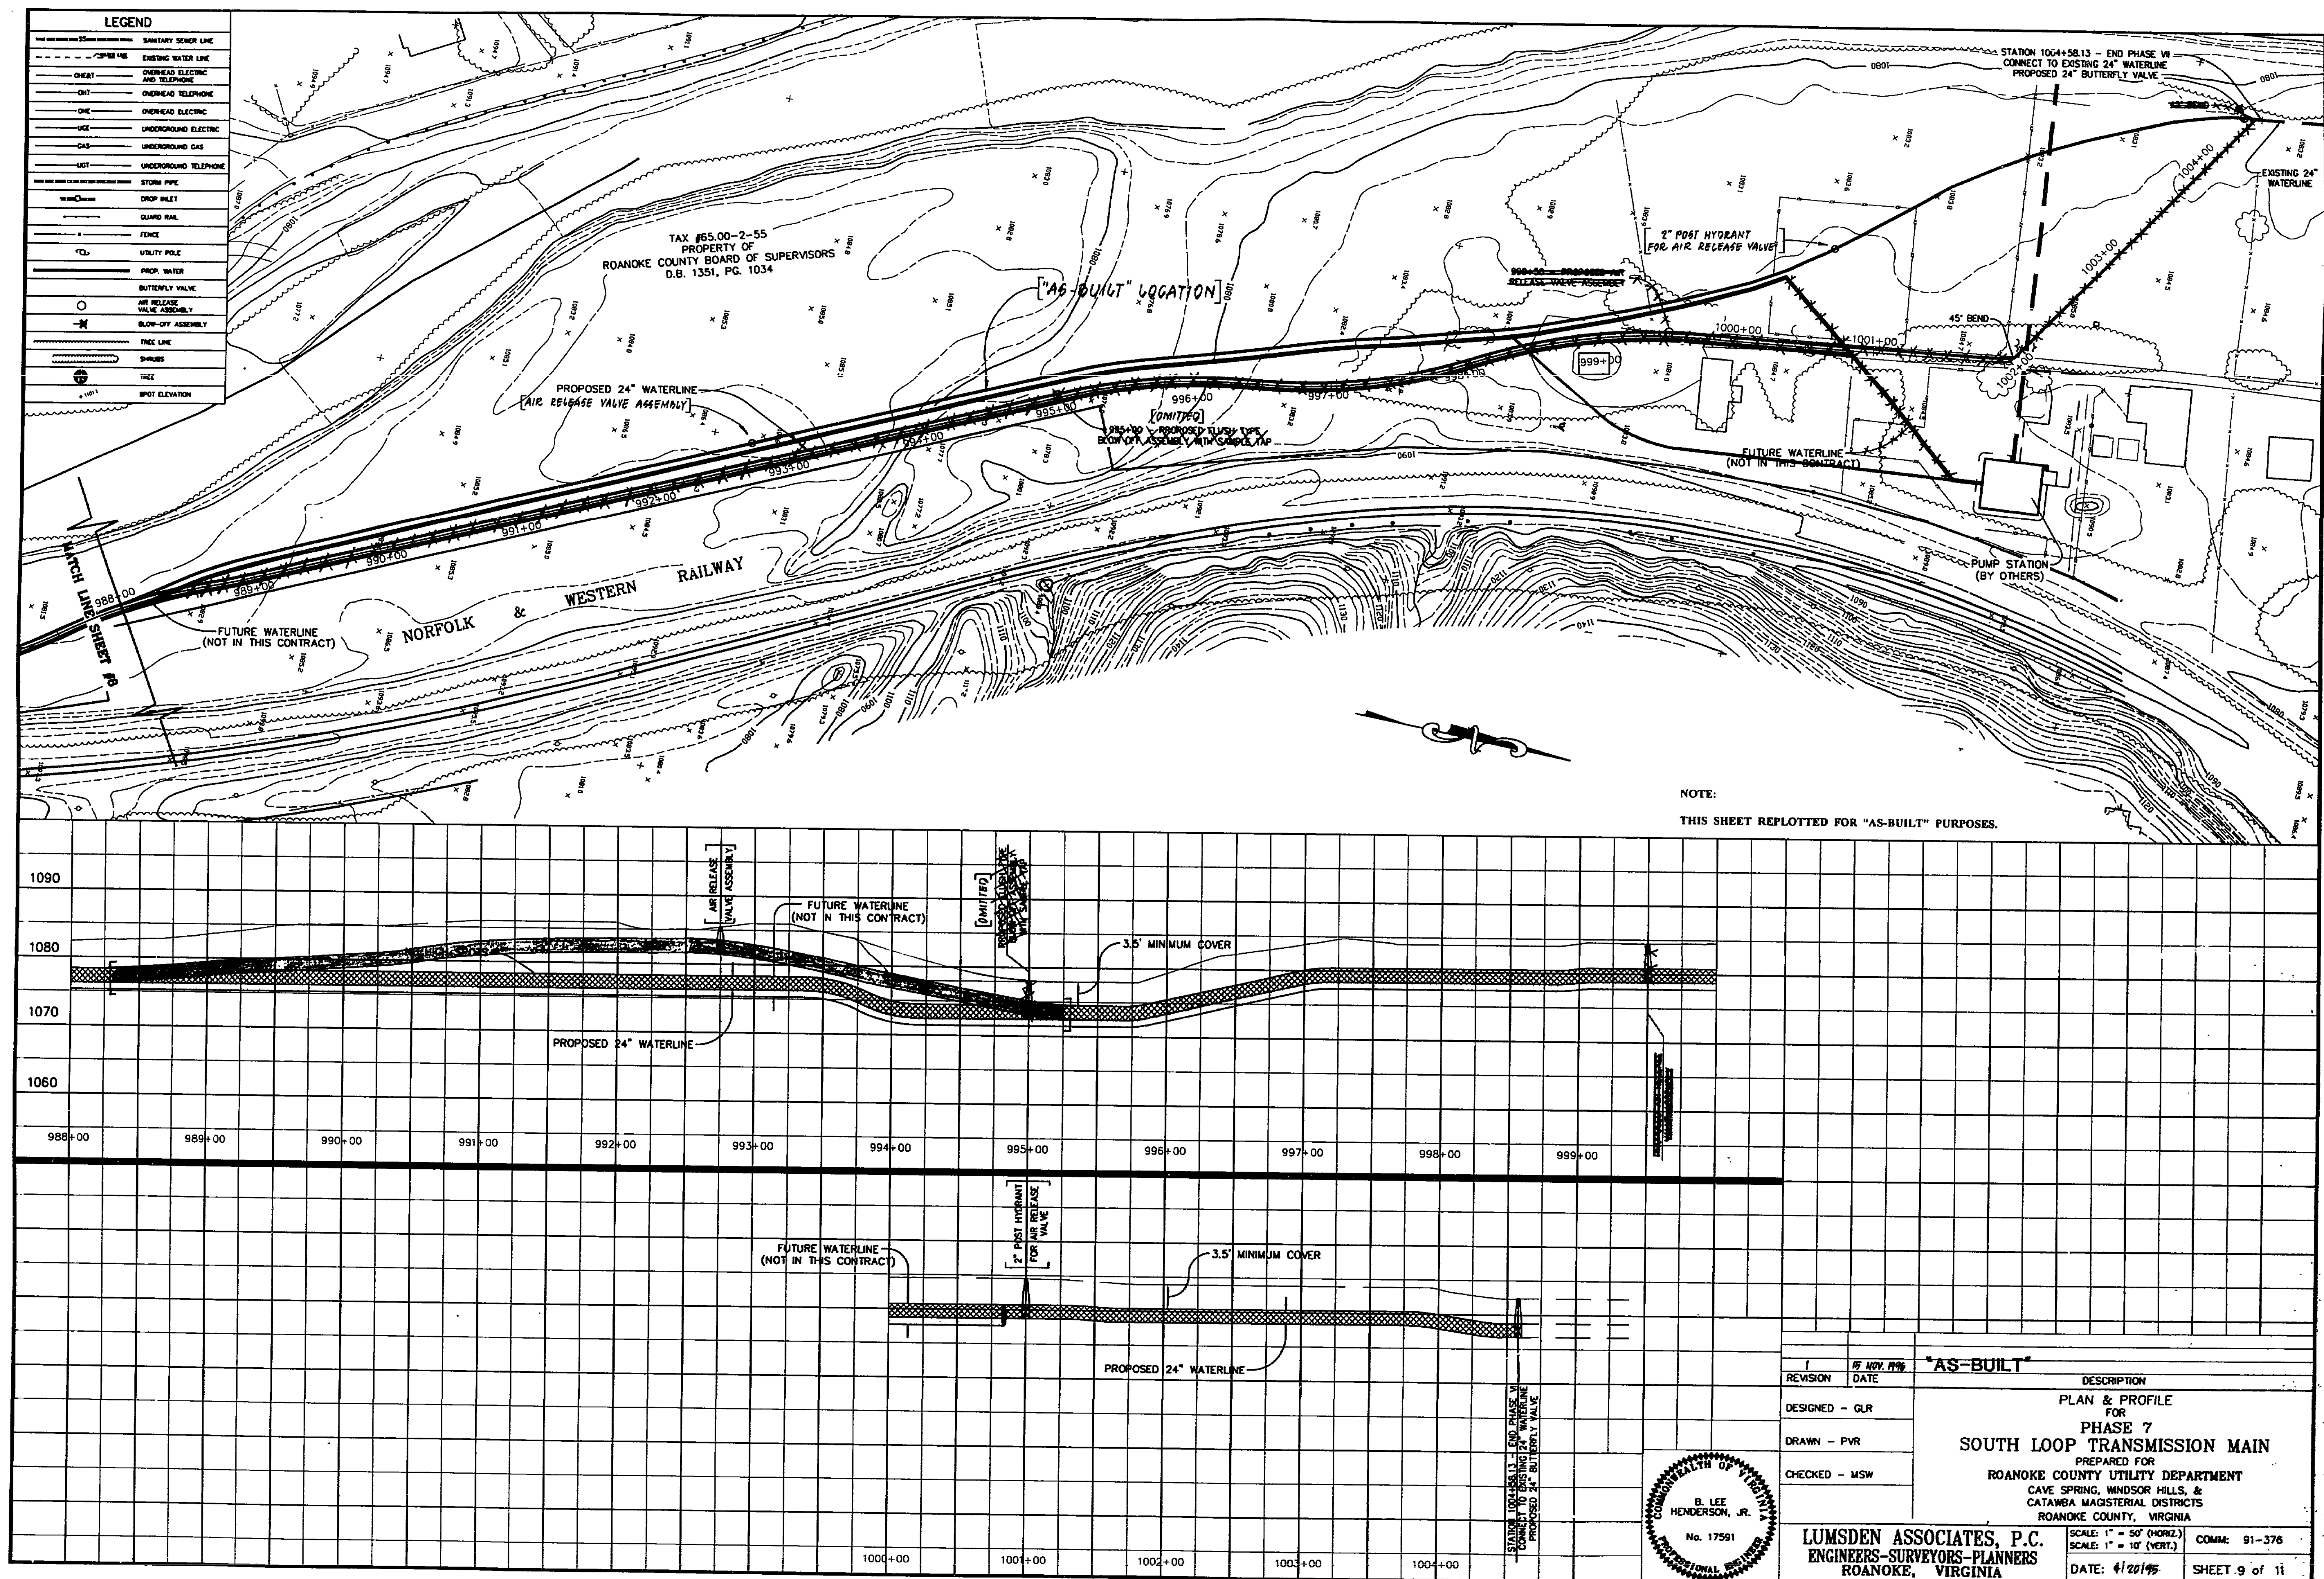

WT-0550