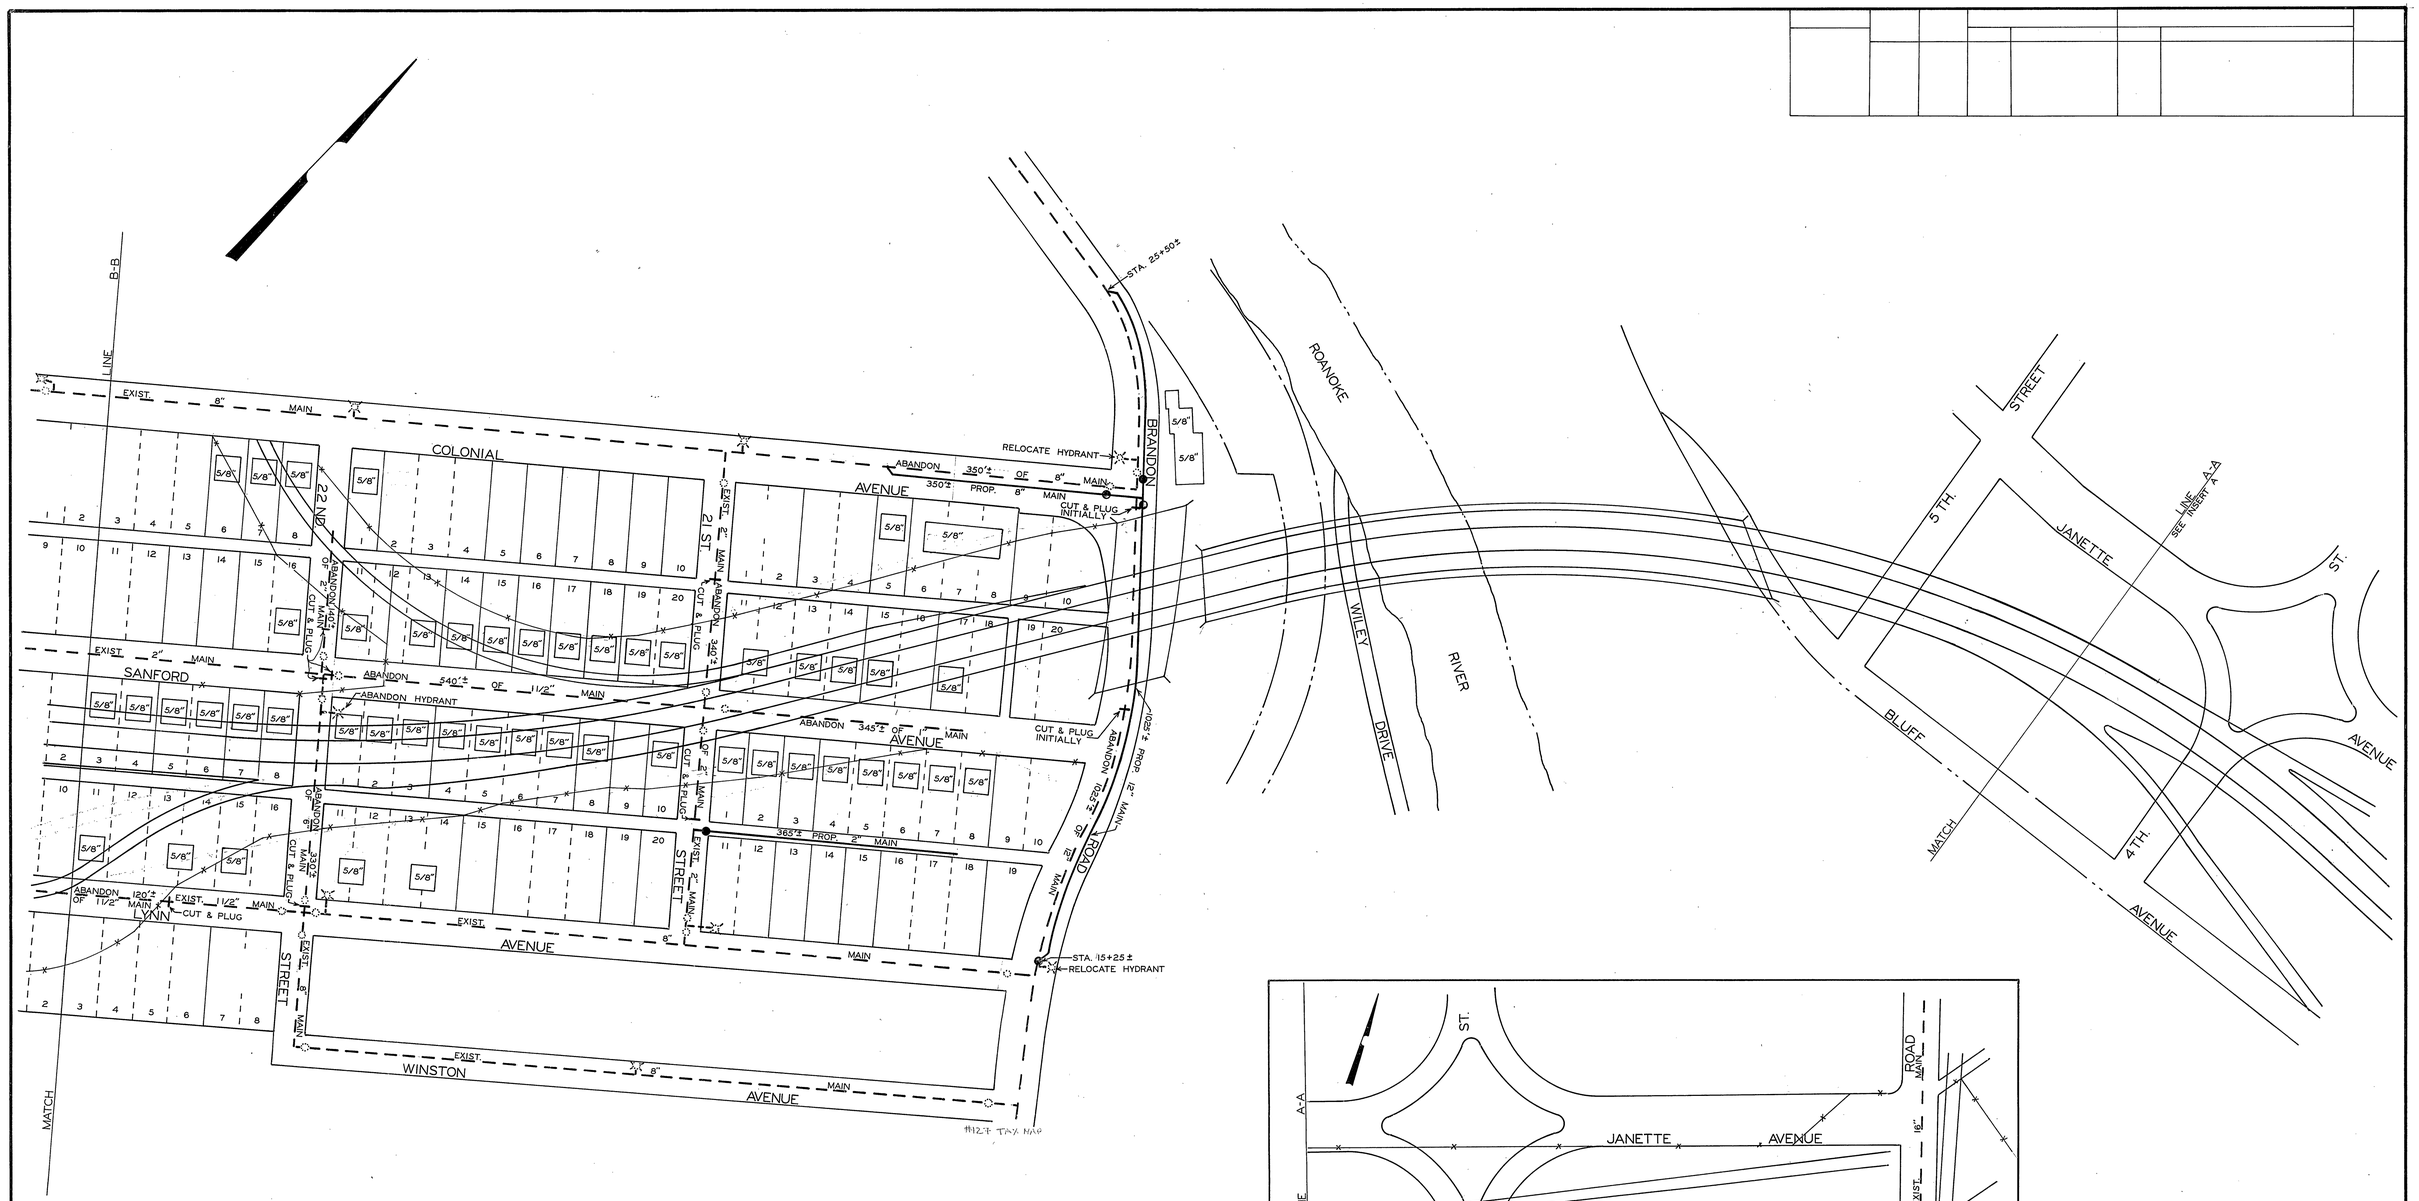

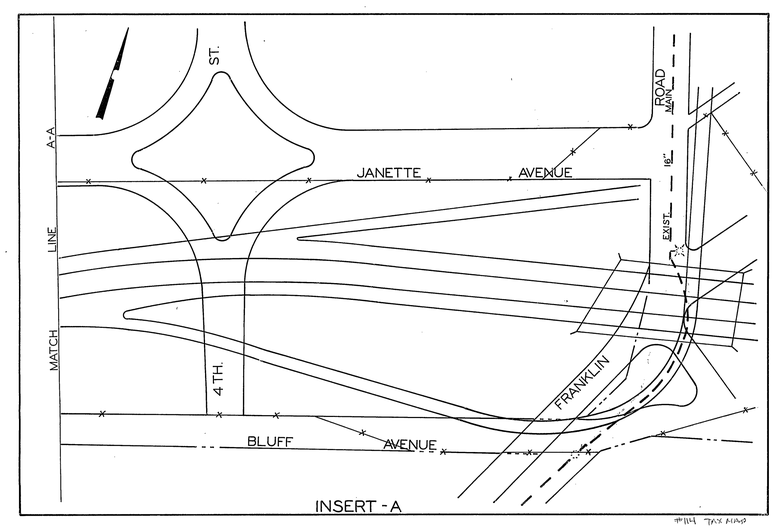

INSERT - A

WATER CHART				
FEET MAIN	SIZE	VALVE	VAULT	BOX
F.H. COMP.				
F.H. STUB ONLY				
SERV. NO. BY				
MAIN INS. BY				
NO. 3/4" SERV. INS.				
CITY OR CO.				
DEPT. INSP.				

L. B. Lin — DIRECTOR UTILITIES & OPERATIONS — 7-9-76 DATE

Thomas F. Brady — CITY ENGINEER OF ROANOKE, VA. — 7-8-76 DATE

DIRECTOR OF PUBLIC WORKS — DATE

AGENT FOR ROANOKE PLANNING COMM. — DATE

REVISED - 2-13-76
7-8-76

"As-built" for proposal

SHEET 1

75 - 19