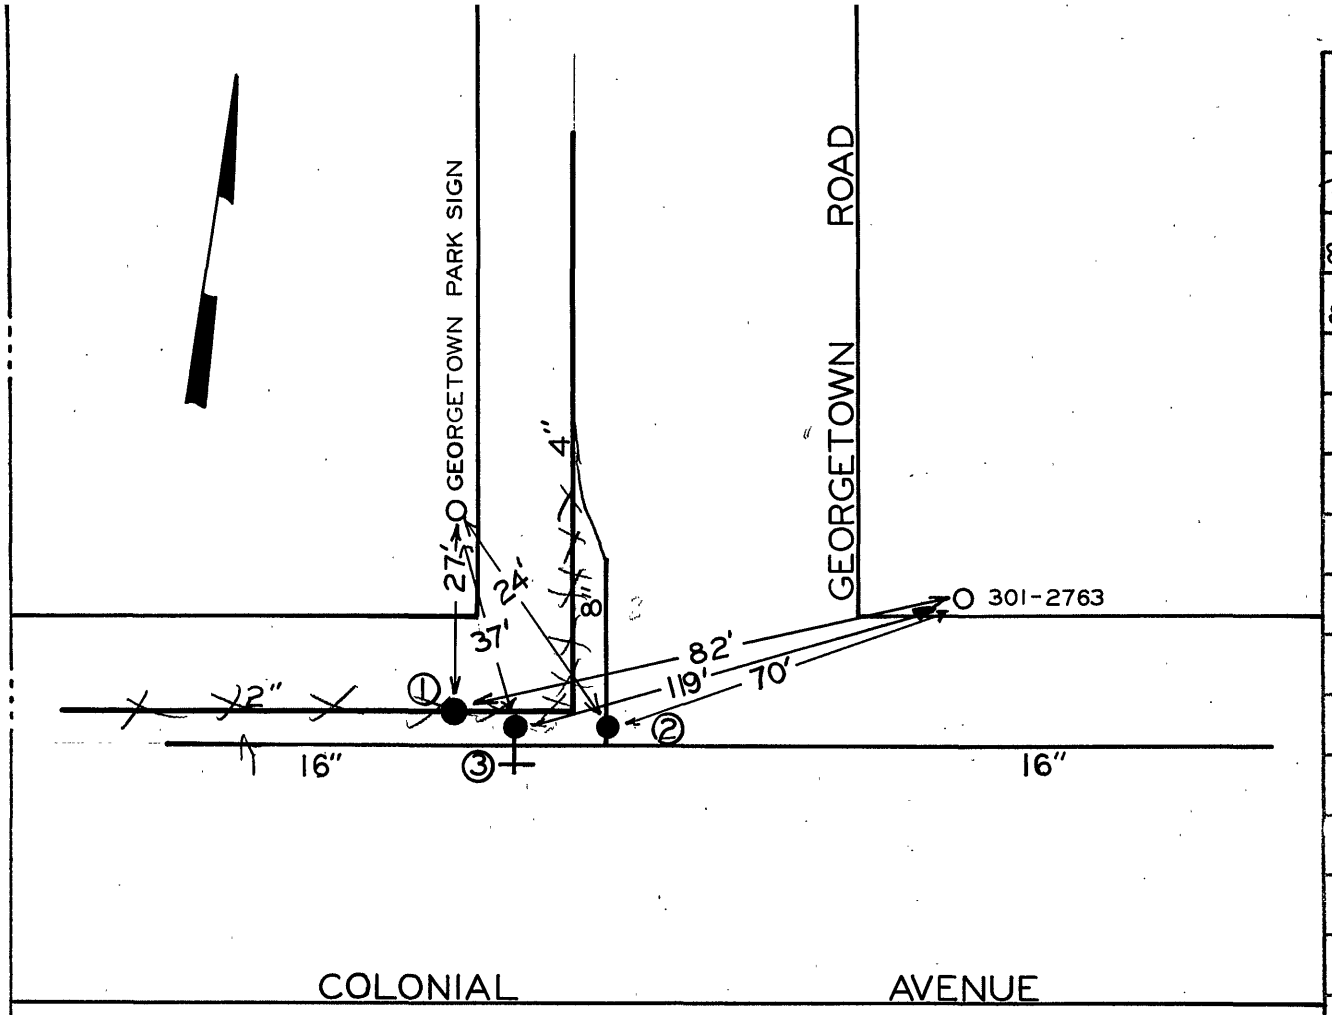

DATE	NO.	SIZE	MAKE	OPEN	TURNS
~~1-69~~	~~1~~	~~4"~~	~~MUELLER~~	~~L~~	
8-75	2	8	MUELLER	R	
8-75	3	16	MUELLER	R	

CITY OF ROANOKE—WATER DEPT.

VALVE DIAGRAM

COLONIAL AVE & GEORGETOWN RD. S.W.

South County - City Maintained

SEC. MAP 63

DATE **PAGE NO.**

2187