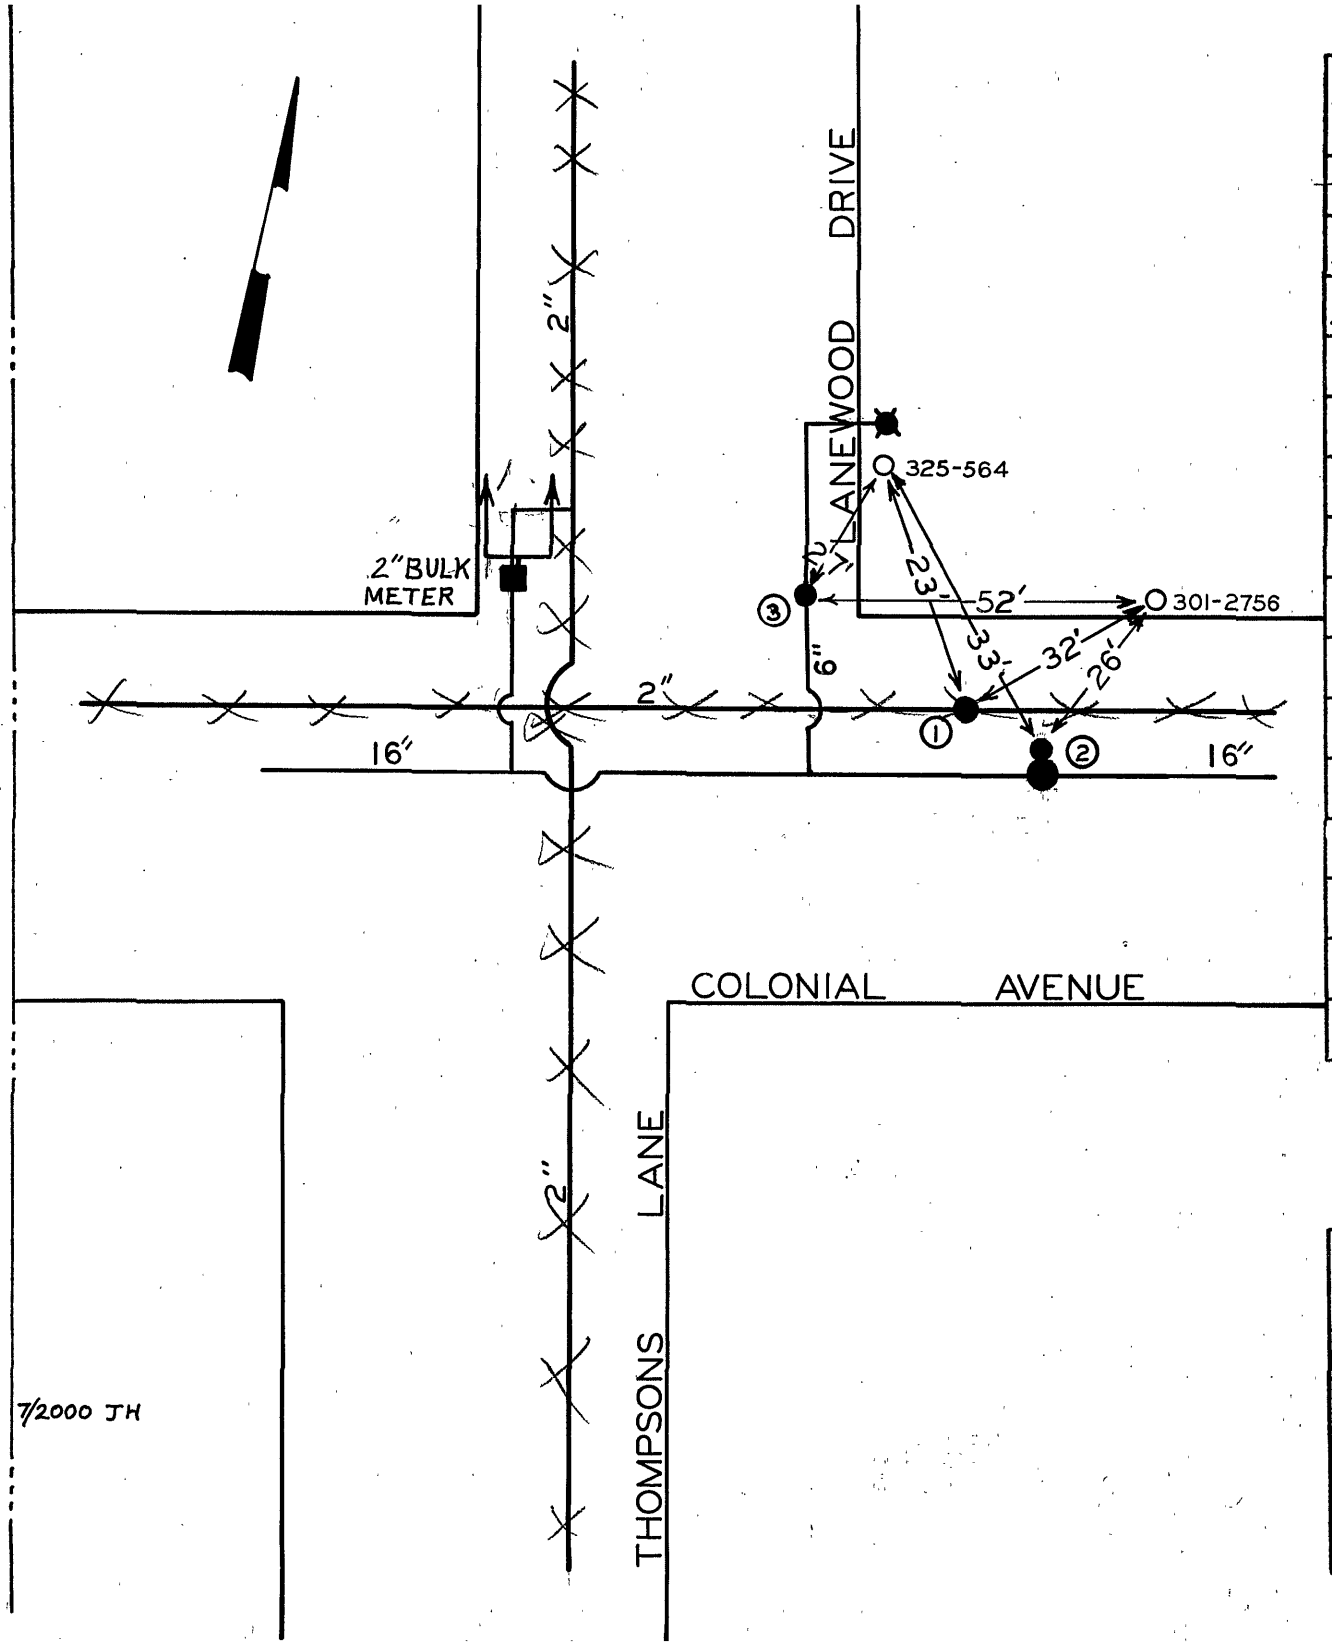

DATE	NO.	SIZE	MAKE	OPEN	TURNS
~~1-69~~	~~1~~	~~2"~~	~~MISC.~~	~~L~~	
4-76	2	16"	MUELLER	R	
4-76	3	6"	MUELLER	R	
	1	8'E	EPL		

CITY OF ROANOKE—WATER DEPT.

VALVE DIAGRAM

COLONIAL AVE., LANEWOOD DR.
AND THOMPSONS LA. S.W.

SEC. MAP COUNTY 64

DATE **PAGE NO.**