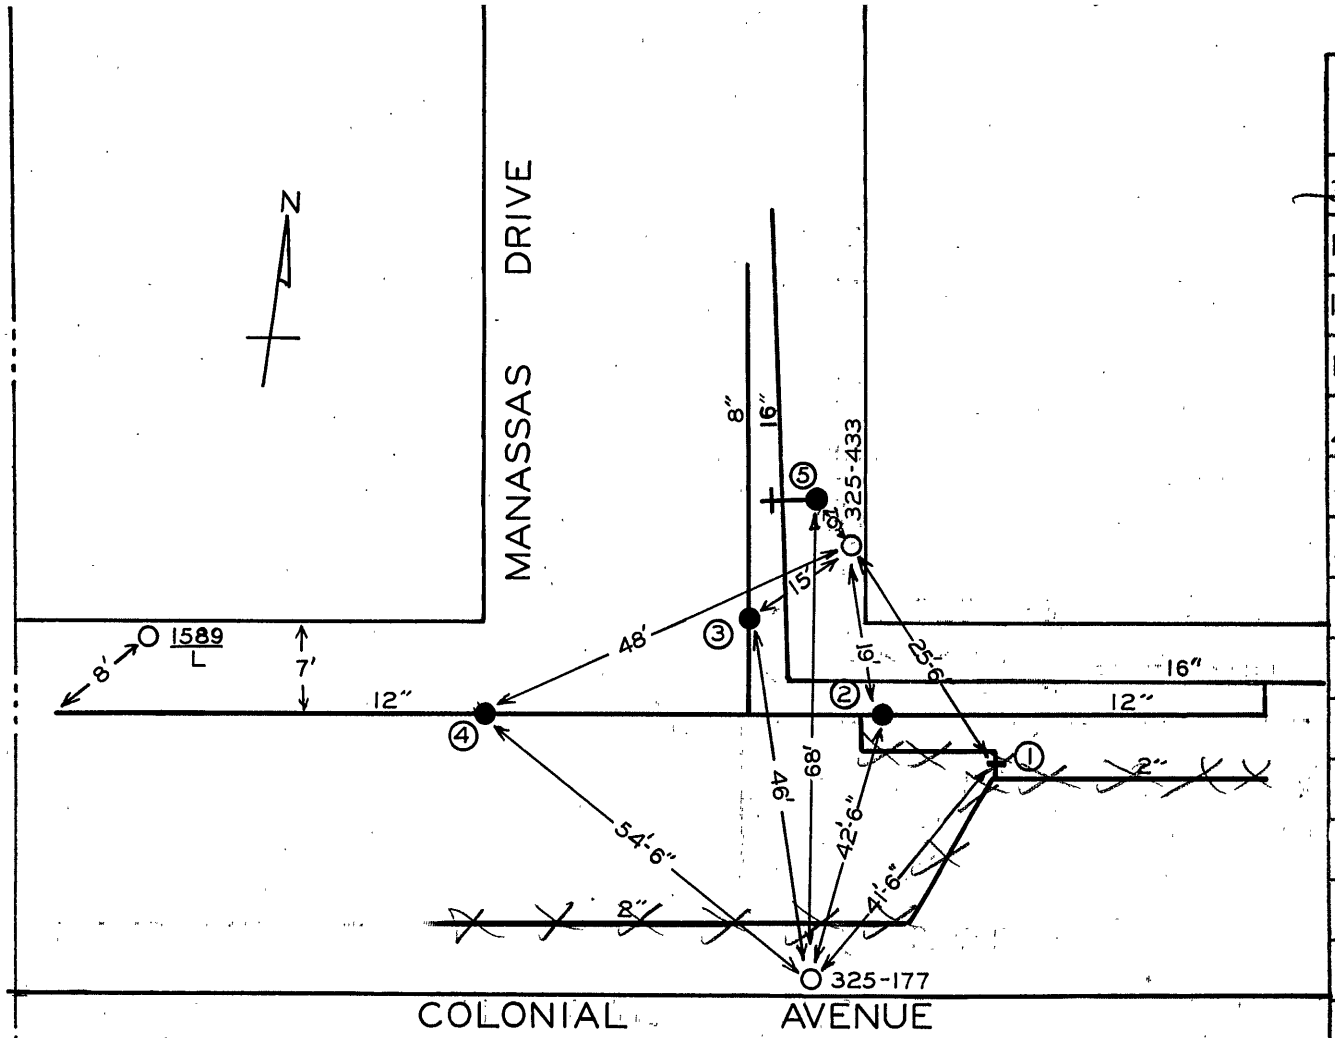

DATE	NO.	SIZE	MAKE	OPEN	TURNS
~~3-68~~	~~1~~	~~2"~~	~~MISC.~~	~~L~~	
10-69	2	12"	MUELLER	R	
10-69	3	8"	MUELLER	R	
10-69	4	12"	MUELLER	R	
4-76	5	16"	MUELLER	R	

CITY OF ROANOKE—WATER DEPT.

VALVE DIAGRAM

COLONIAL AVE. & MANASSAS DR. S.W.

South County City Maintained

SEC. MAP 64

DATE **PAGE NO.**

2/87