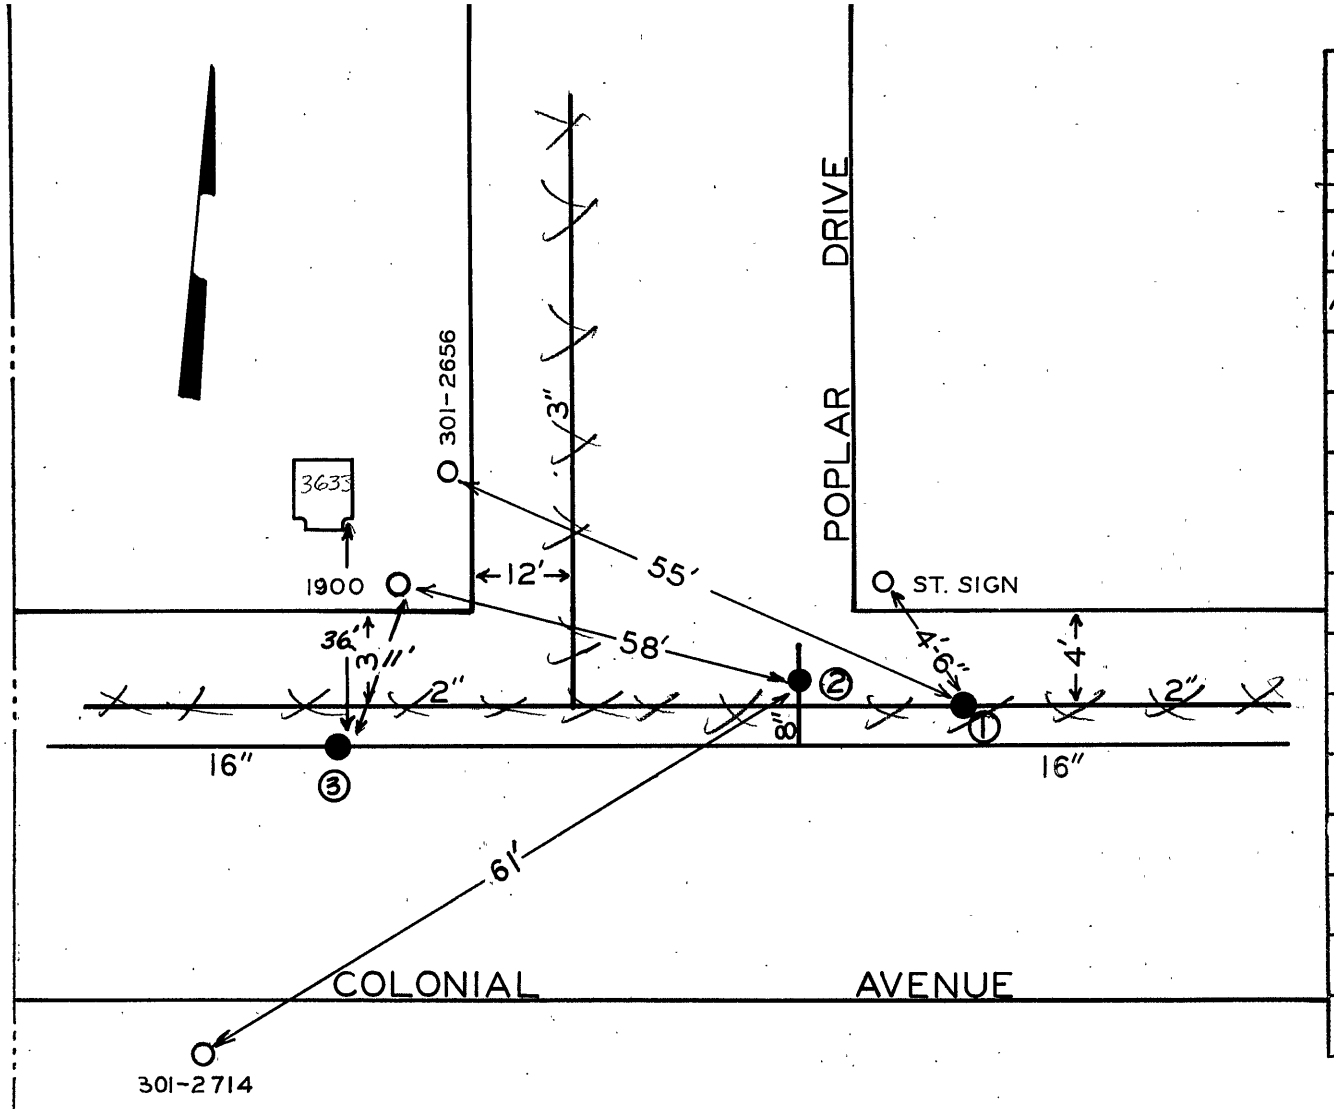

DATE	NO.	SIZE	MAKE	OPEN	TURNS
~~1-69~~	~~1~~	~~2"~~	~~MISC.~~		
2 75	2	8"	MUELLER	R	
10-76	3	1"		AIR	VALVE
	1	4'S	NPL		

CITY OF ROANOKE—WATER DEPT.

VALVE DIAGRAM

COLONIAL AVE. & POPLAR DR. S.W.

(South County) - City Maintained

SEC. MAP 64

DATE **PAGE NO.**