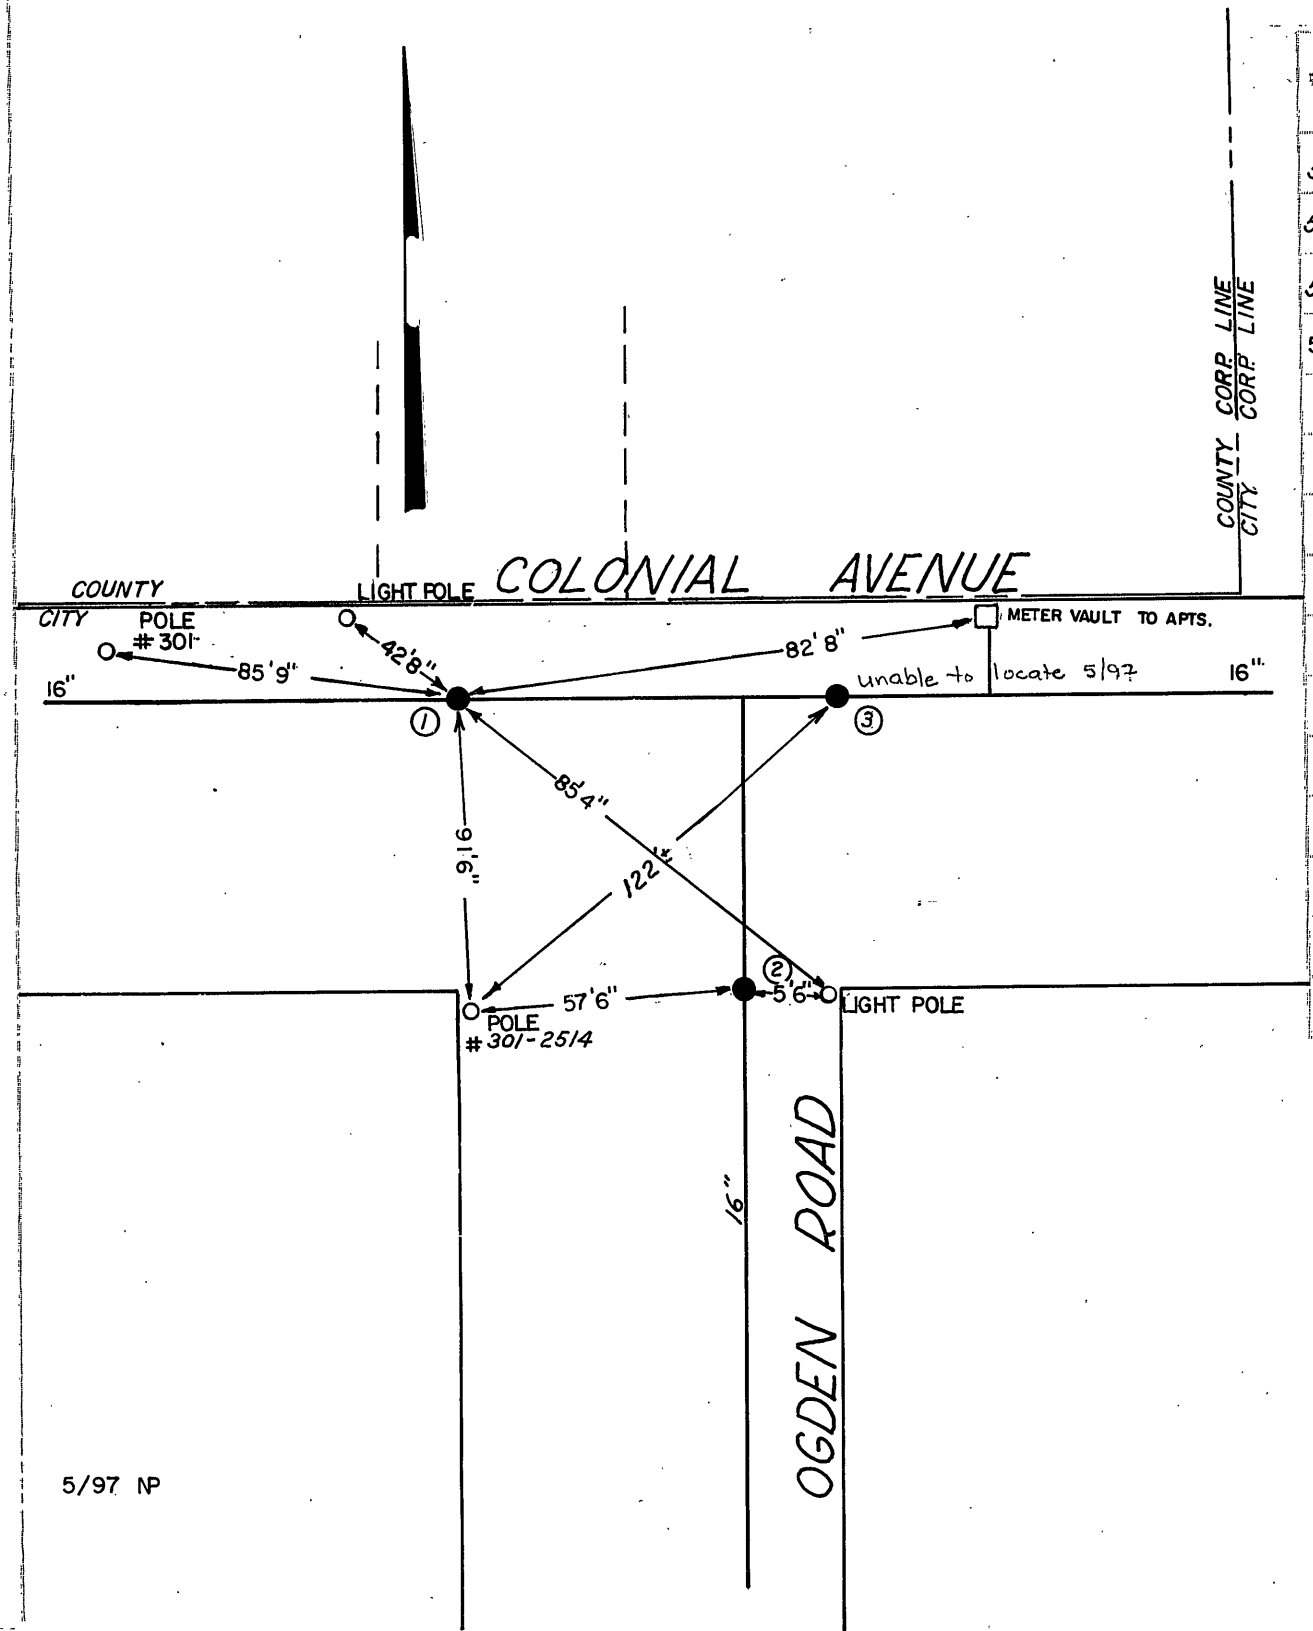

DATE	NO.	SIZE	NAME	DITCH	TURNS
5-75	1	16"	DARLING	R	
5-75	2	16"	DARLING	R	
5-75	3	16"	MUELLER	R	
5-97			METER VAULT		

CITY OF ROANOKE — WATER DEPT.

VALVE DIAGRAM

COLONIAL AVENUE &

OGDEN ROAD S.W.

SEC. MAP 157; COUNTY 63 (4)

DATE PAGE NO.