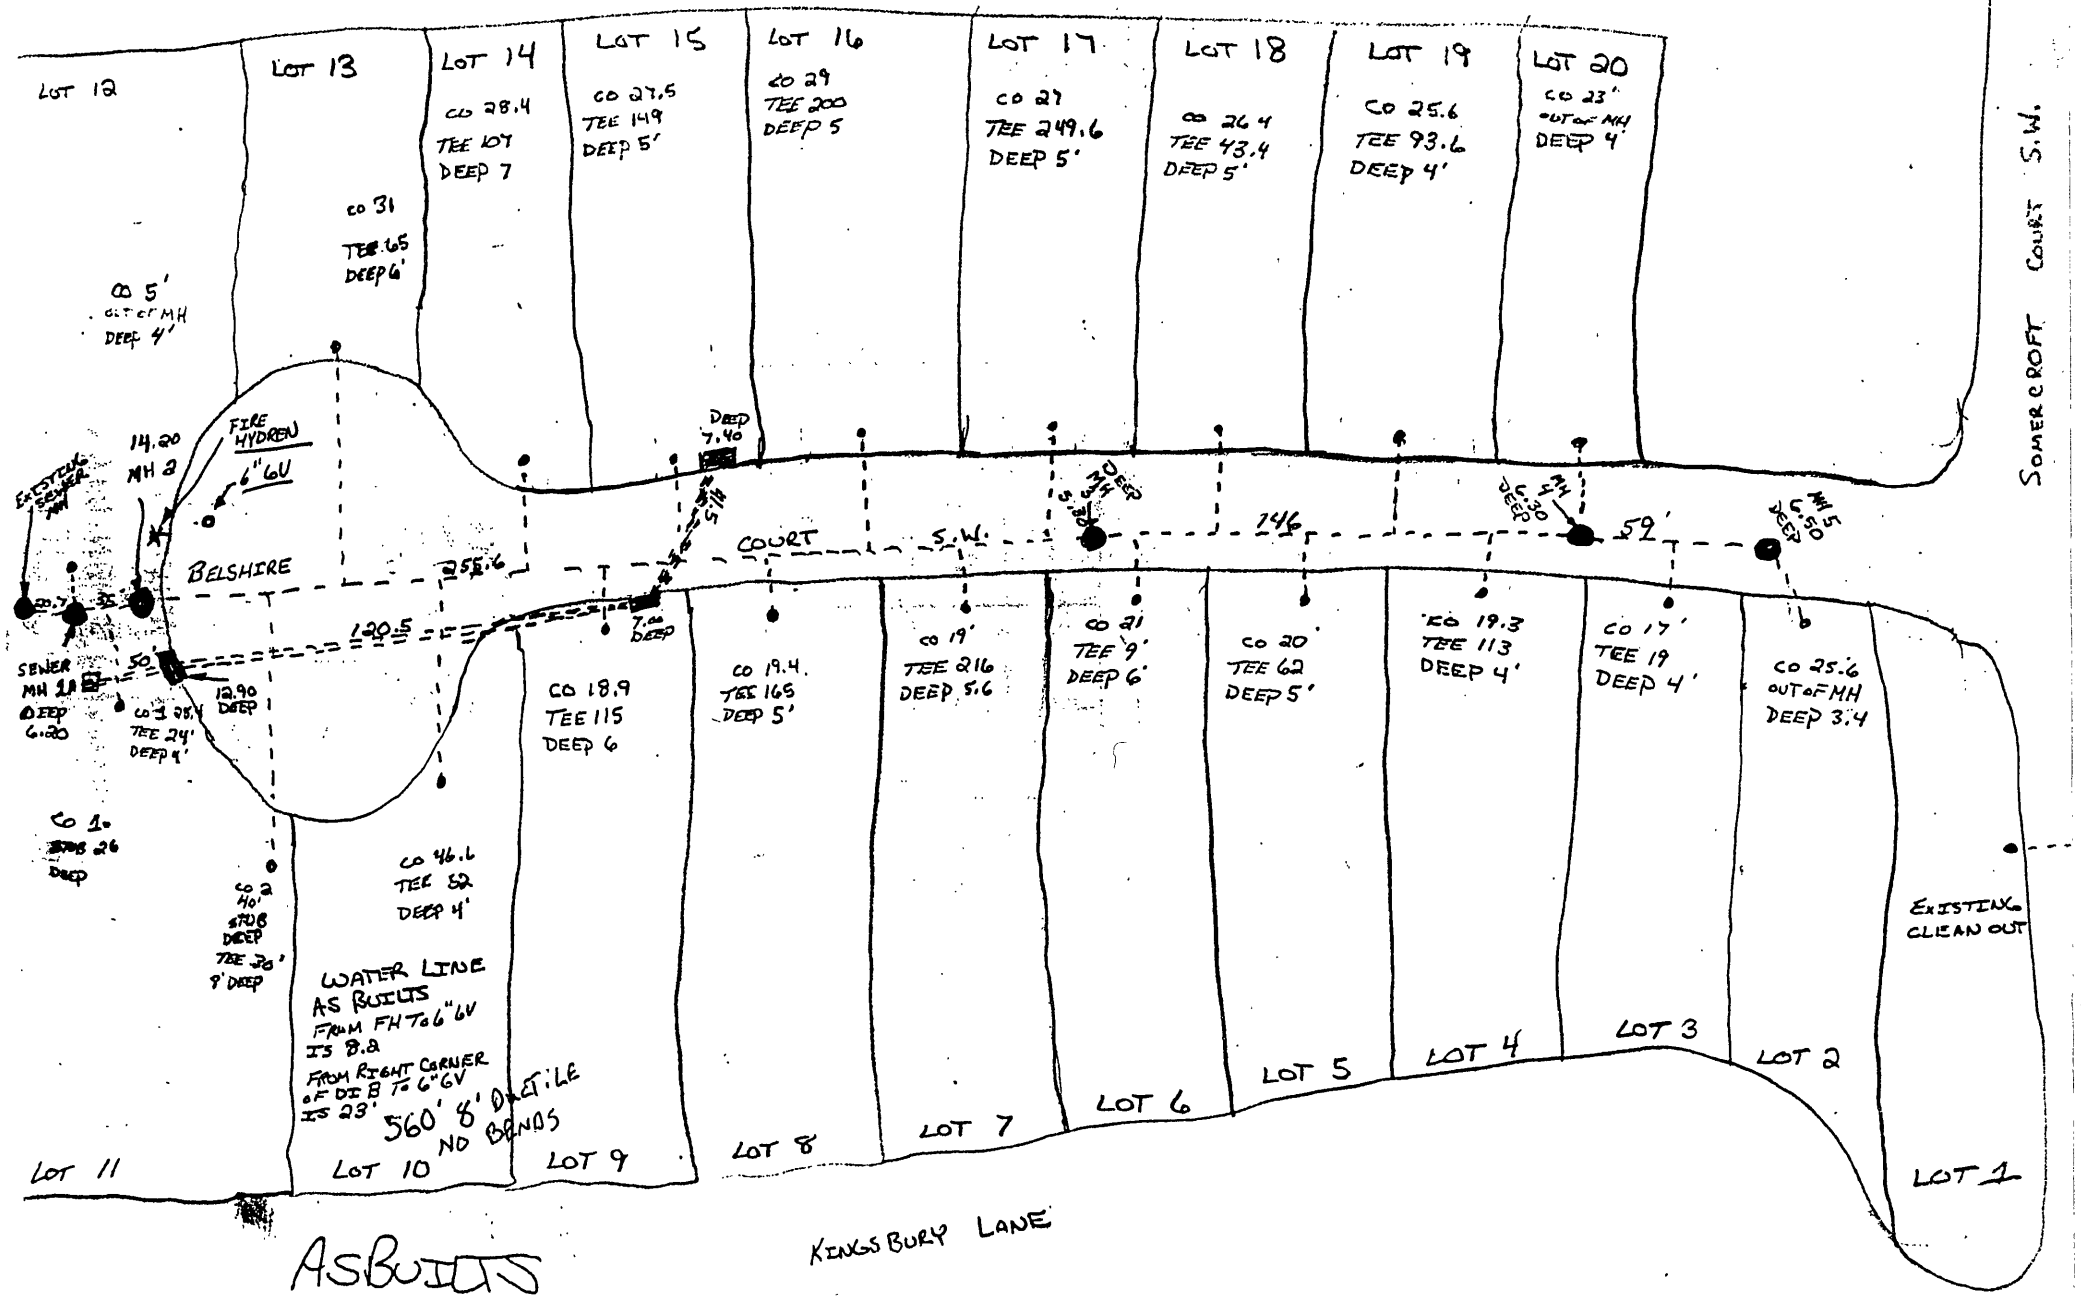

AS BUILTS
SOUTHWOOD
THE COACH HOMES

3/4/2004