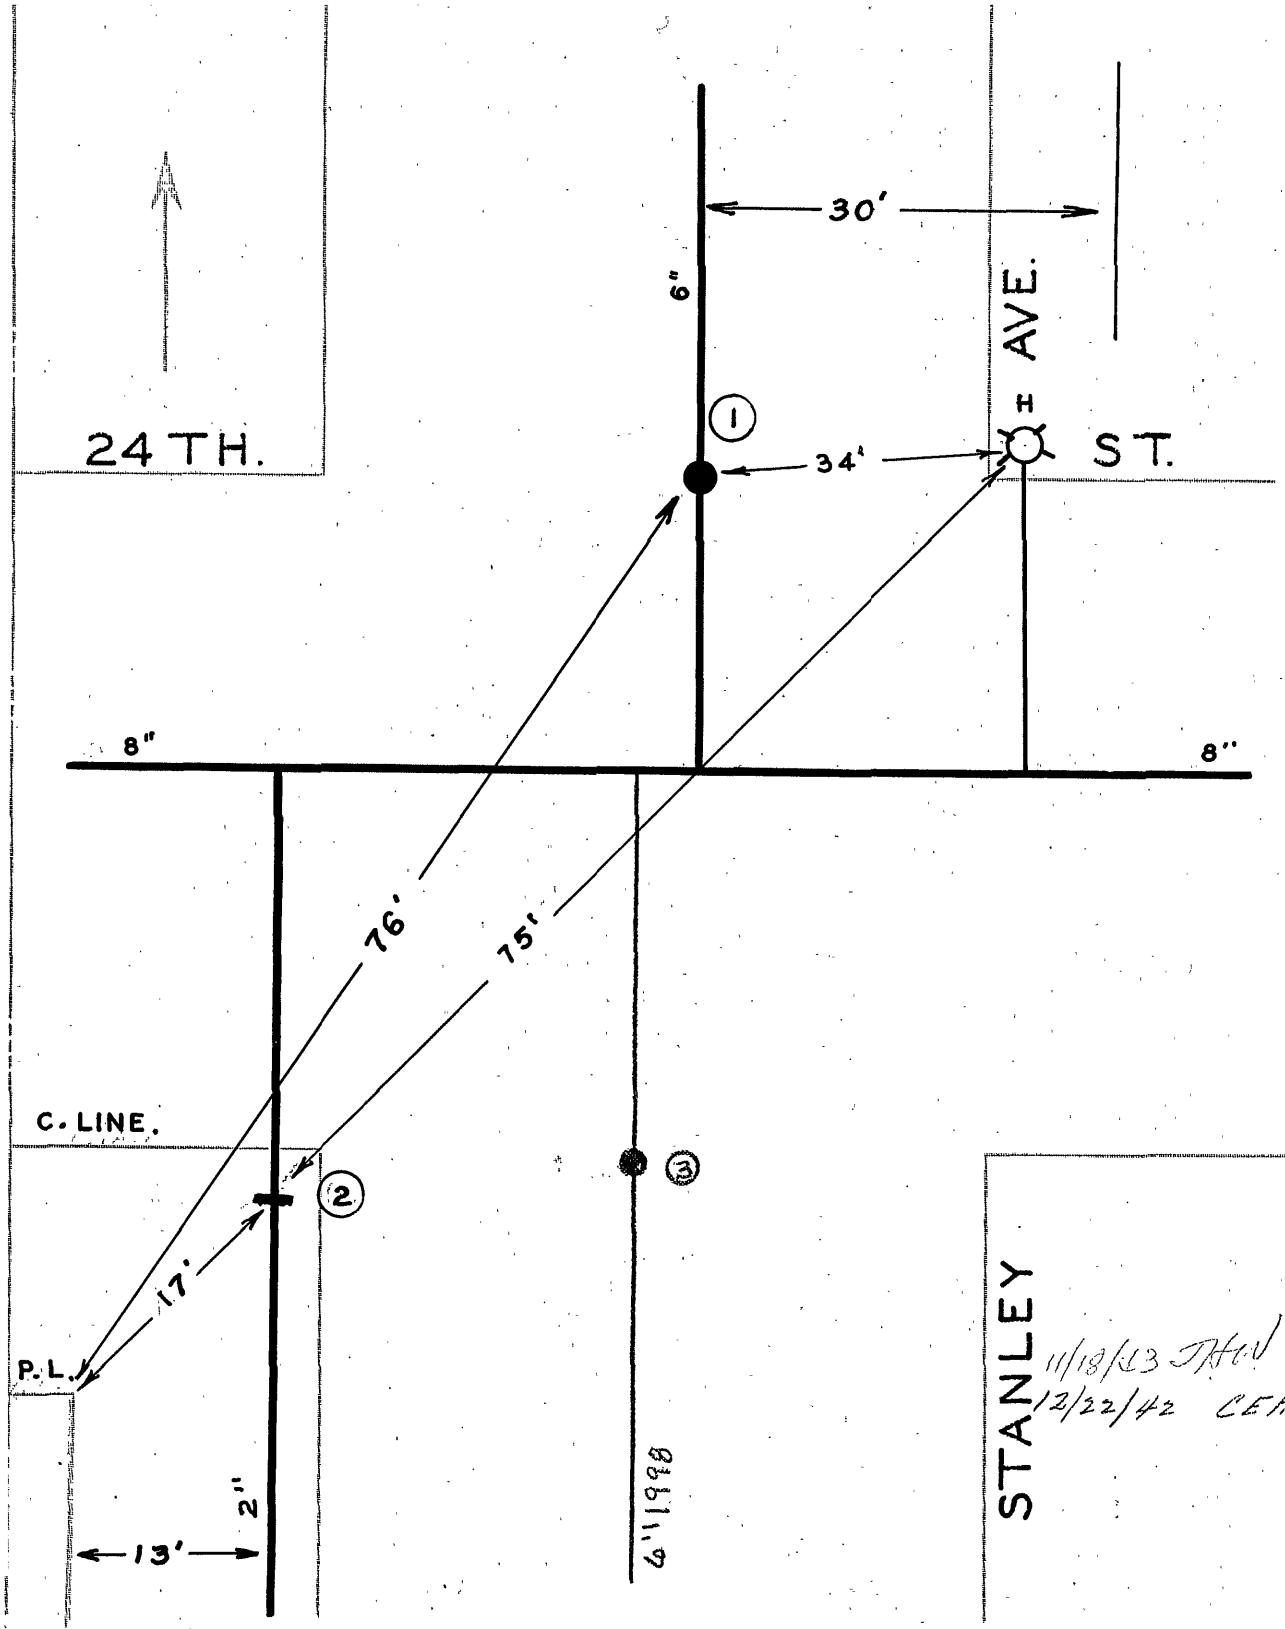

DATE	NO.	SIZE	MAKE	OPEN	TURNS
1932	1	6"		R	20 1/2
1924	2	2"		R	6 1/2
1998	3	6"			
	1	0	NPL		
	2	12'-N	SPL		

11/18/43 JHW
12/22/42 CEH

CITY OF ROANOKE—WATER DEPT
VALVE DIAGRAM
STANLEY AVE. & 24TH.
ST. SOUTH EAST

SEC. MAP 408

DATE PAGE NO. S.W.221