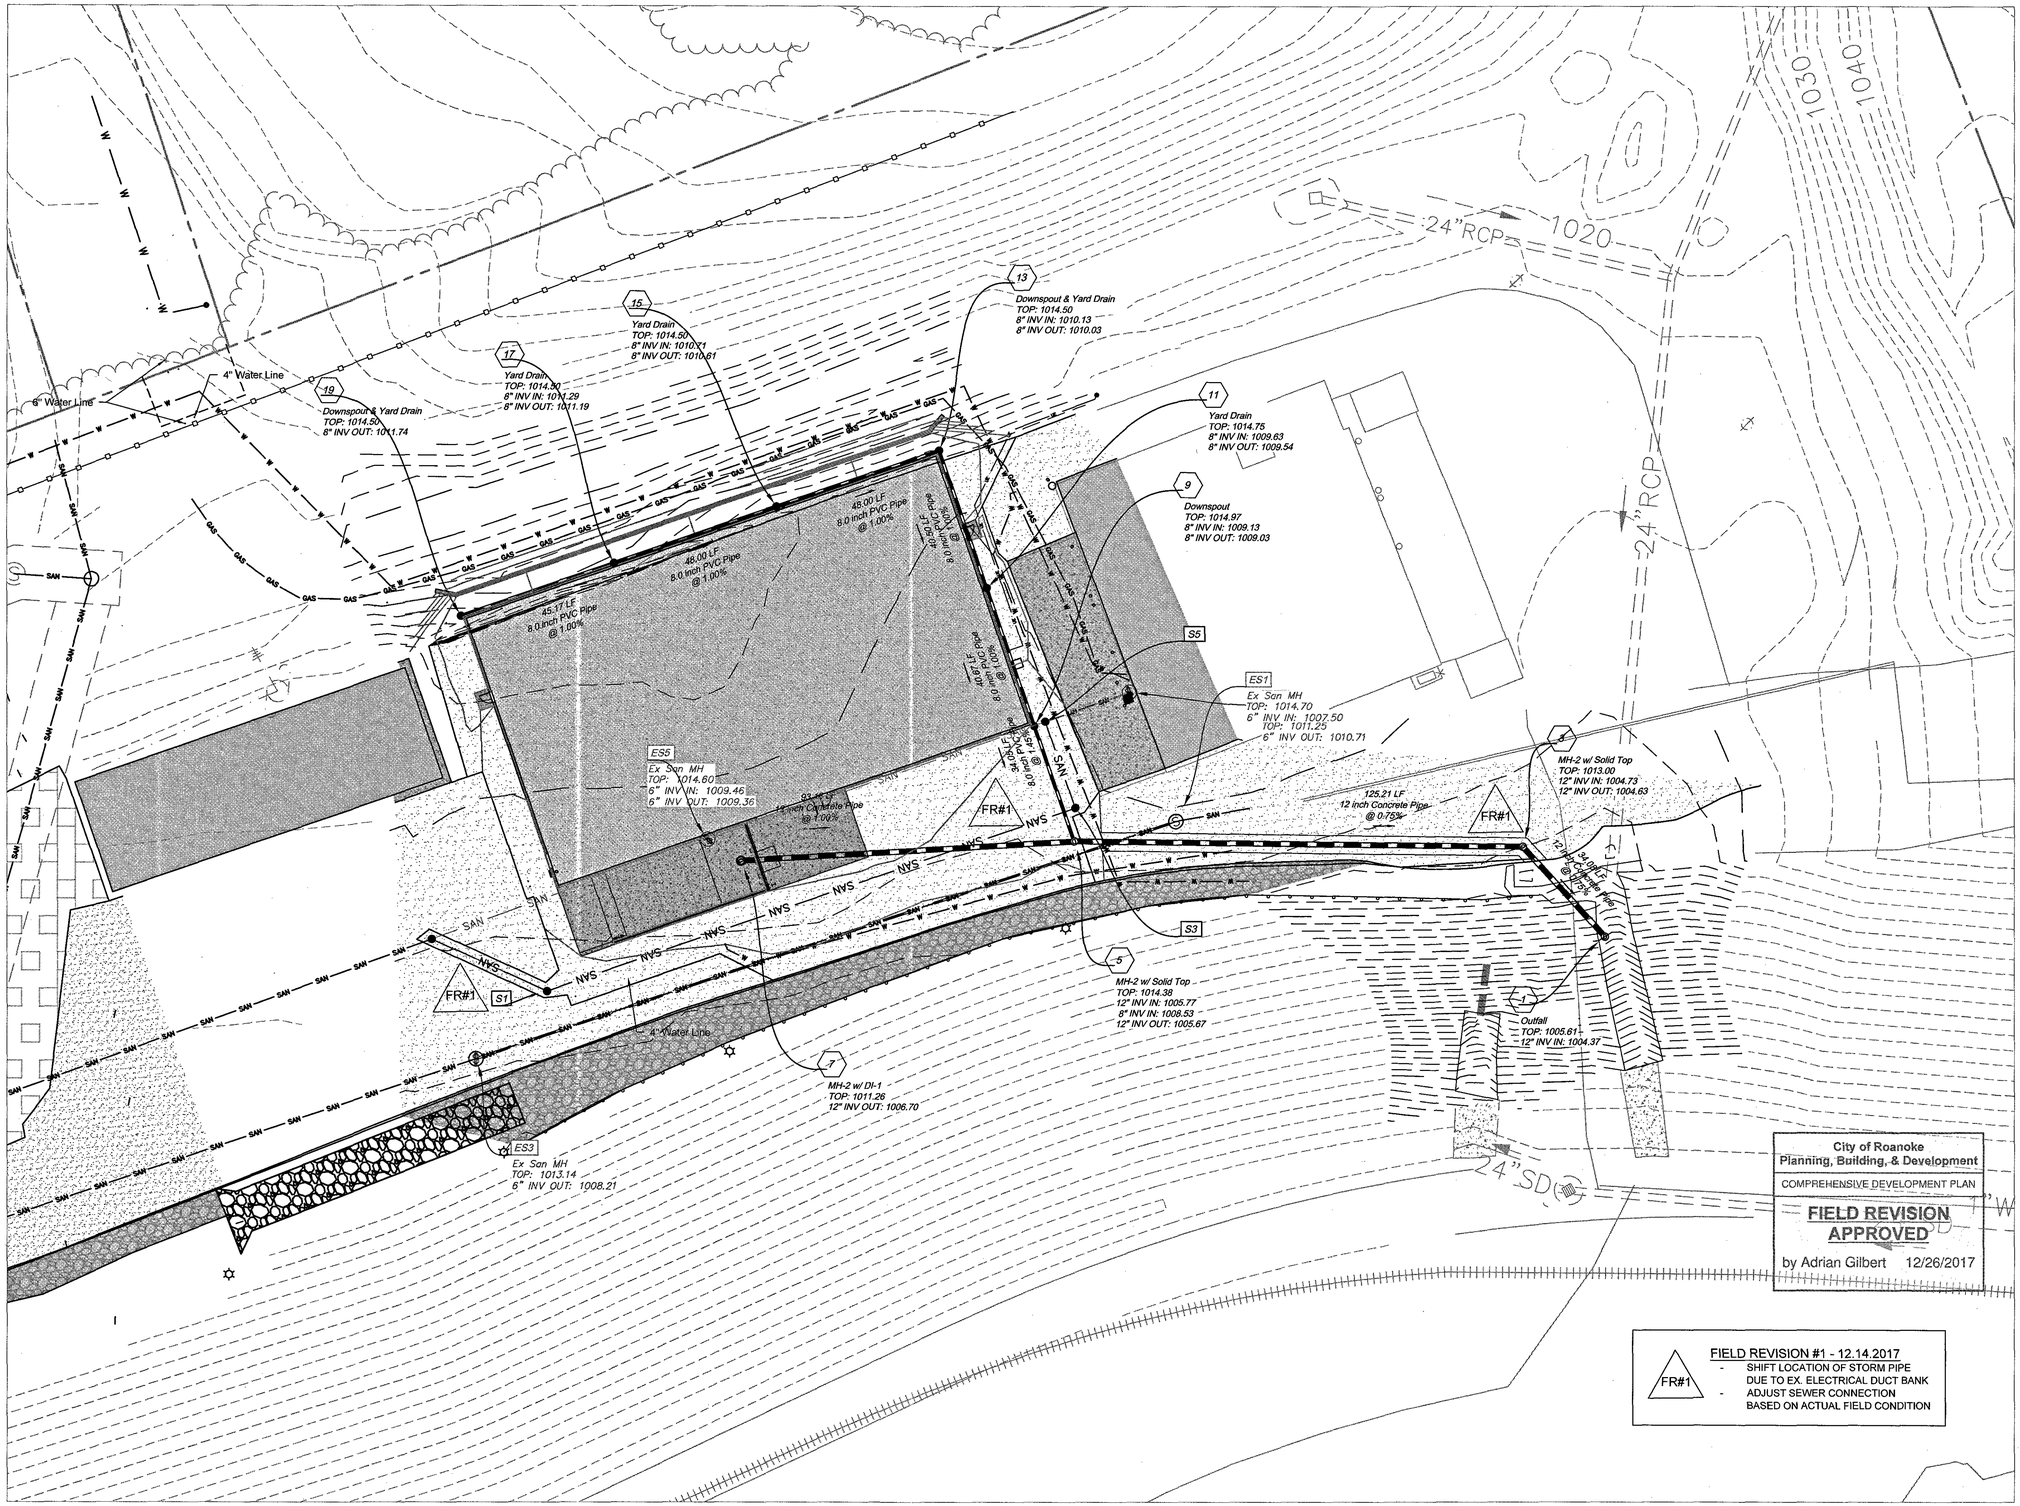

parker
DESIGN GROUP
2122 Carolina Ave, SW
Roanoke, VA 24014
Ph: 540-387-1153
Fax: 540-389-5767
1915-B W. Cary Street
Richmond, VA 23220
Phone: 804-358-2947
Fax: 804-359-9645
www.parkerdg.com

These documents are the property of Parker Design Group(PDG) and may not be reproduced or used without the express permission of PDG. Any reuse of these documents without authorization of PDG will be at the sole risk of the individual or entity utilizing said documents.

COMMONWEALTH OF VIRGINIA
CLYDE D. SPENCER
Lic. No. 35456
12/14/2017
PROFESSIONAL ENGINEER

STEEL DYNAMICS
Spare Parts Warehouse 2017
Tax # 6021103
City of Roanoke, Virginia

REVISIONS:

Rev. 1: per City Comments 2017-09-13
Rev. 1: Completed 2017-09-15
Rev. 2: Client Information
Rev. 2: Completed 2017-09-27
Rev. 3: Revised for consistency
Rev. 3: Completed 2017-10-16
Rev. 4: Revised for Water & Dev.
Rev. 4: Completed 2017-11-01
Field Rev. #1: Utility Conflicts
Field Rev. #1: Completed 2017-12-14

DESIGNED BY:	CDS
DRAWN BY:	CDS
CHECKED BY:	SRB

DATE:
September 18, 2017

SHEET TITLE:
Utility Plan
See Sheet C03 for As-Built

SCALE:

SHEET NO.
C04

Path: W:\2017 Projects\17-0043.03 Steel Dynamics\6 DWG\Active Engineering Production\Referenced Drawings\5-PROPOSED STORM NETWORK C04 C08 12.14.2017.dwg