


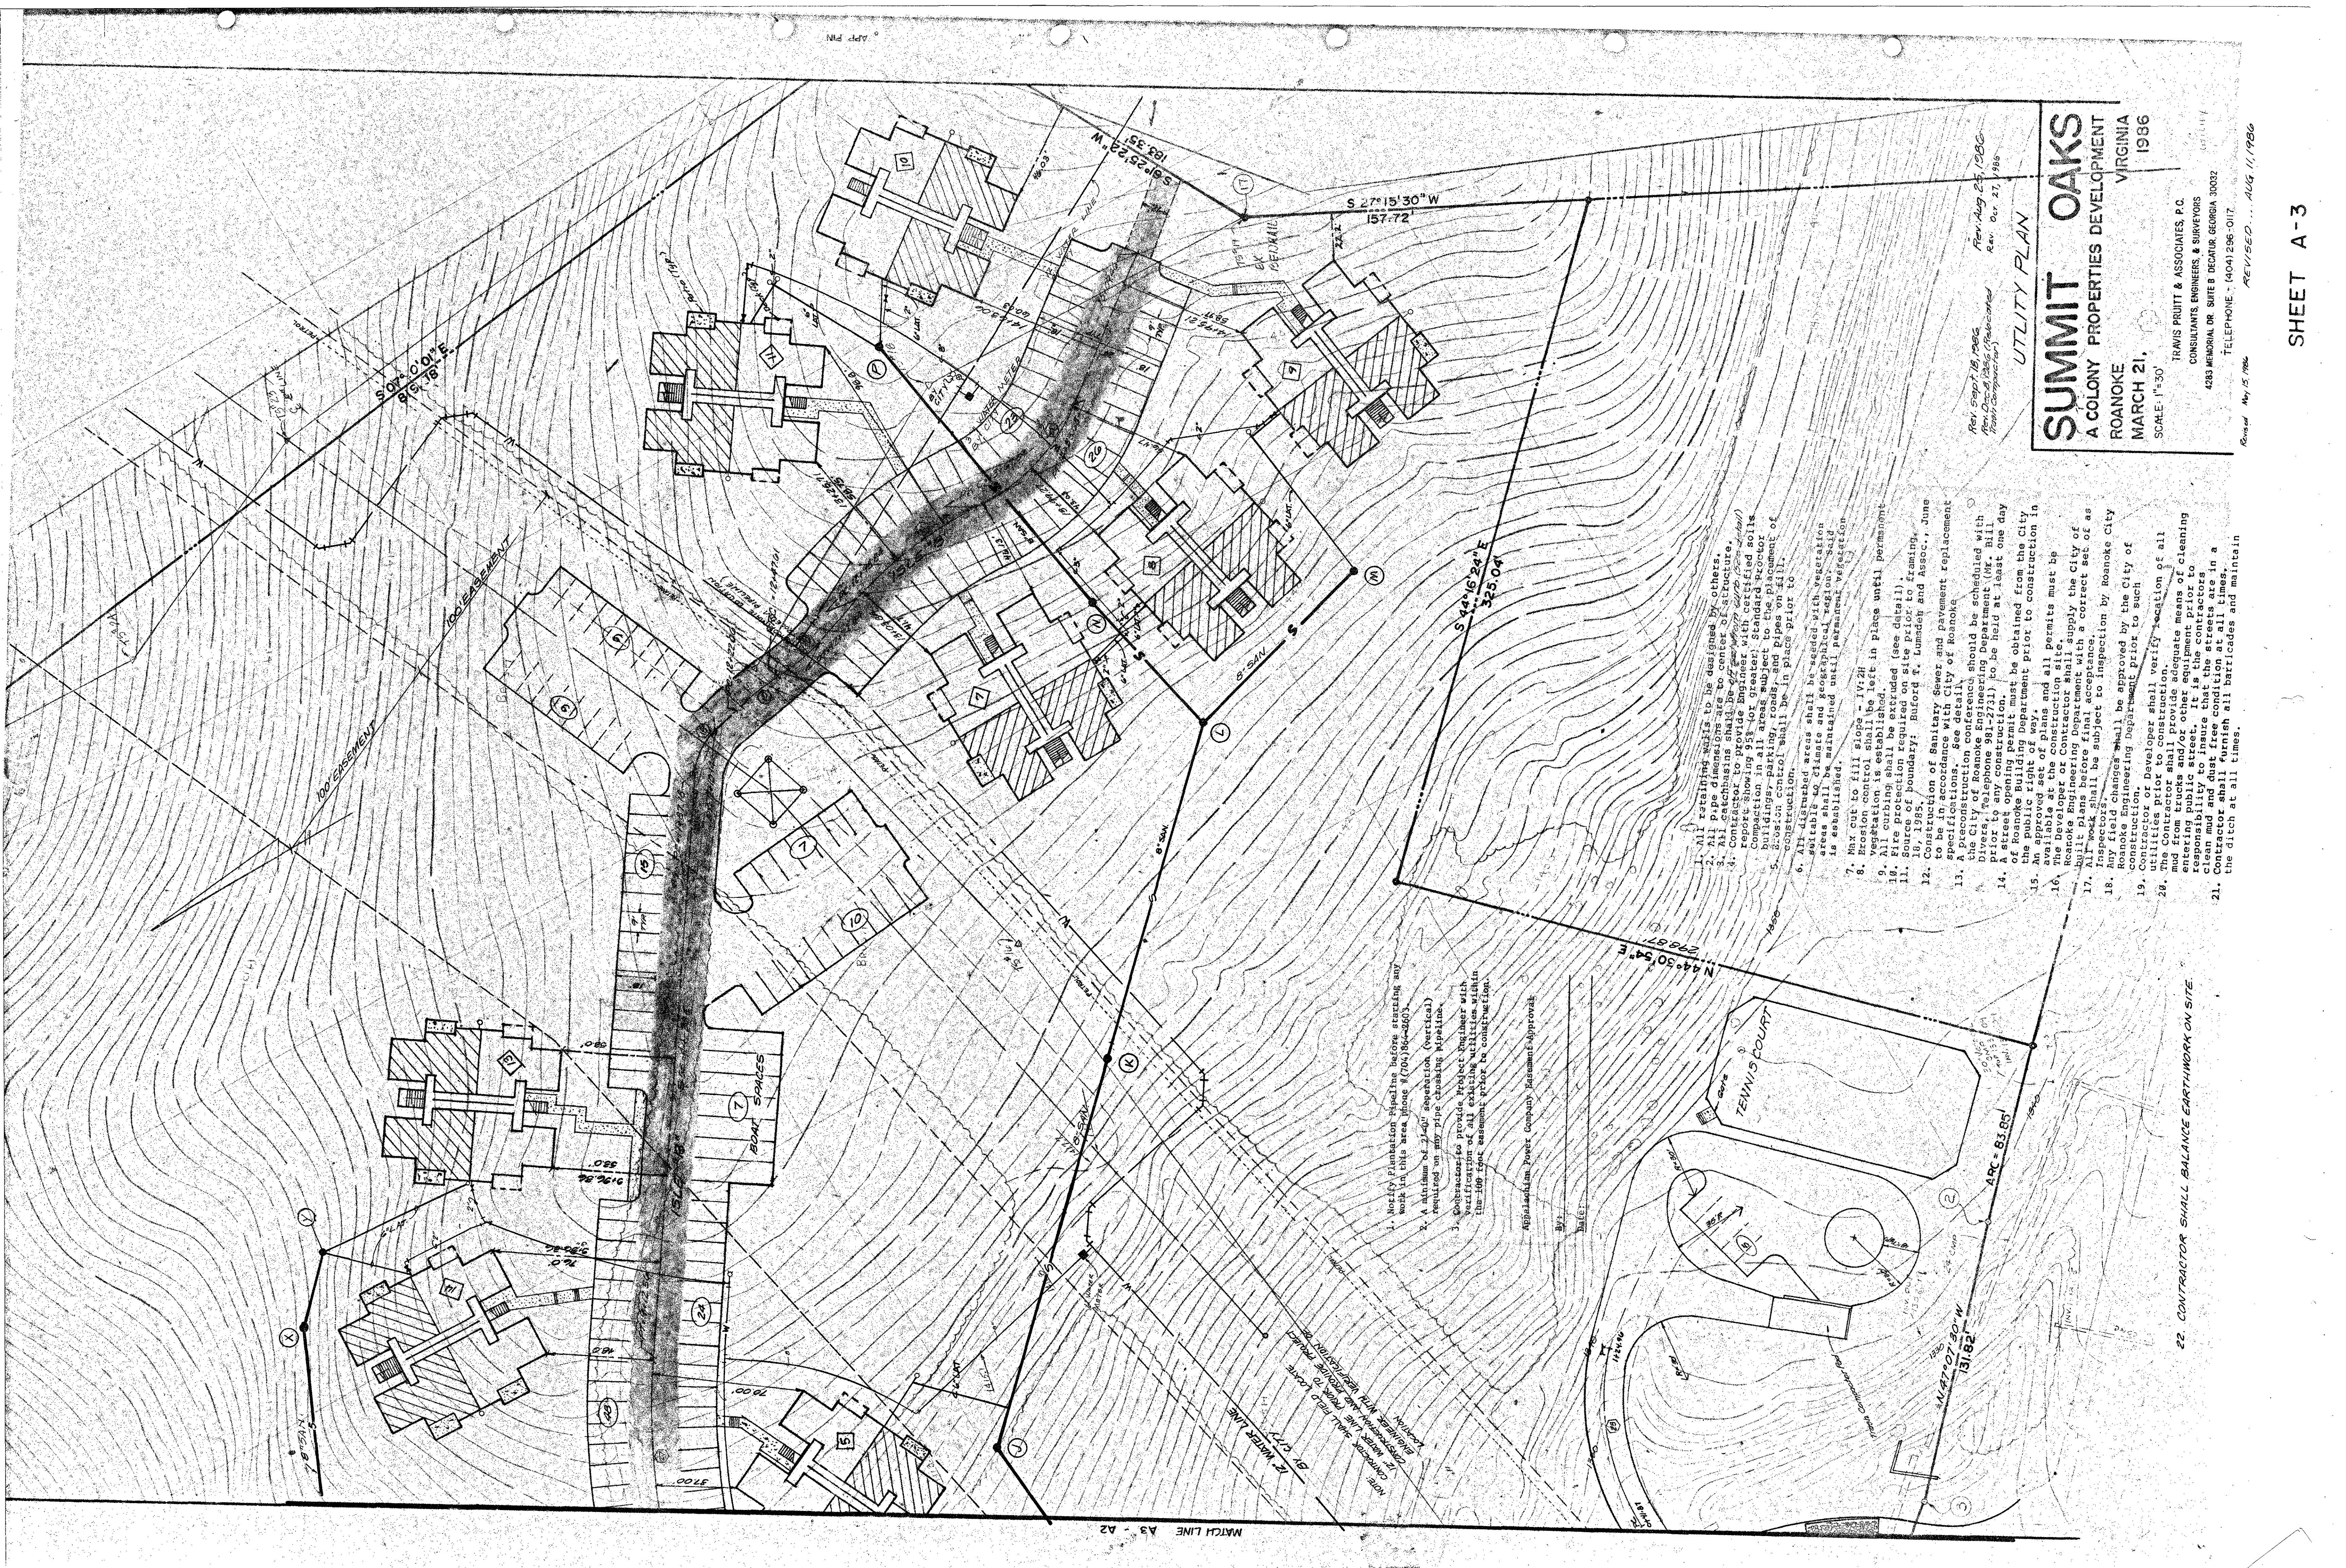

1. Notify Plantation Pipeline before starting any work in this area phone #7041864-2603.
2. A minimum of 24" separation (vertical) required on any pipe crossing pipeline.
3. Contractors provide Project Engineer with verification of all existing utilities within the 100 foot easement prior to construction.

Appalachian Power Company Easement Approval

1. All retaining walls to be designed by others.
2. All pipe discharges are to center of structure.
3. All catchbasins to be designed by others.
4. Contractor to provide a report showing 95% for engineer with certified soils compaction in all areas subject to the placement of buildings, parking, roads, and placement of fill.
5. Erosion control shall be in place prior to construction.
6. All disturbed areas shall be seeded with vegetation and shall be maintained until permanent vegetation is established.
7. May cut to fill slope - 1V:2H.
8. Erosion control shall be left in place until permanent vegetation is established.
9. All curbing shall be extruded (see detail).
10. Fire protection shall be required on site prior to framing.
11. Source of boundary: Buford F. Lunadeh and Assoc., June 18, 1985.
12. Construction of Sanitary Sewer and pavement replacement to be in accordance with City of Roanoke specifications. See detail.
13. A preconstruction conference should be scheduled with the City of Roanoke Engineering Department, Hill Divisions, telephone #704-27311 to be held at least one day prior to any construction.
14. A street opening permit must be obtained from the City of Roanoke Building Department prior to construction in the public right of way.
15. Available set of plans and all permits must be available at the construction site.
16. The Developer/Contractor shall supply the City of Roanoke Engineering Department with a correct set of as built plans before final acceptance.
17. All work shall be subject to inspection by Roanoke City inspectors.
18. Roadway changes shall be approved by the City of Roanoke Engineering Department prior to such construction or development.
19. Contractor or Developer shall verify location of all utilities prior to construction.
20. The Contractor shall provide adequate means of cleaning and from trucks and/or other equipment prior to entering public street. It is the responsibility of the Contractor to insure that the street is clean and must be free condition at all times.
21. Contractor shall furnish all barricades and maintain the ditch at all times.

22. CONTRACTOR SHALL BALANCE EARTHWORK ON SITE.

Rev. Sept 18, 1986
Rev. Dec 18, 1986 (Revised)
Rev. Oct 27, 1988

UTILITY PLAN

SUMMIT OAKS
A COLONY PROPERTIES DEVELOPMENT
ROANOKE VIRGINIA
MARCH 21, 1986
SCALE: 1"=30'

TRANS PRUITT & ASSOCIATES, P.C.
CONSULTANTS, ENGINEERS & SURVEYORS
4233 MEMORIAL DR. SUITE 8 DECATUR, GEORGIA 30032
TELEPHONE: (404) 296-0117

Revised May 15, 1986
REVISED... AUG 11, 1986