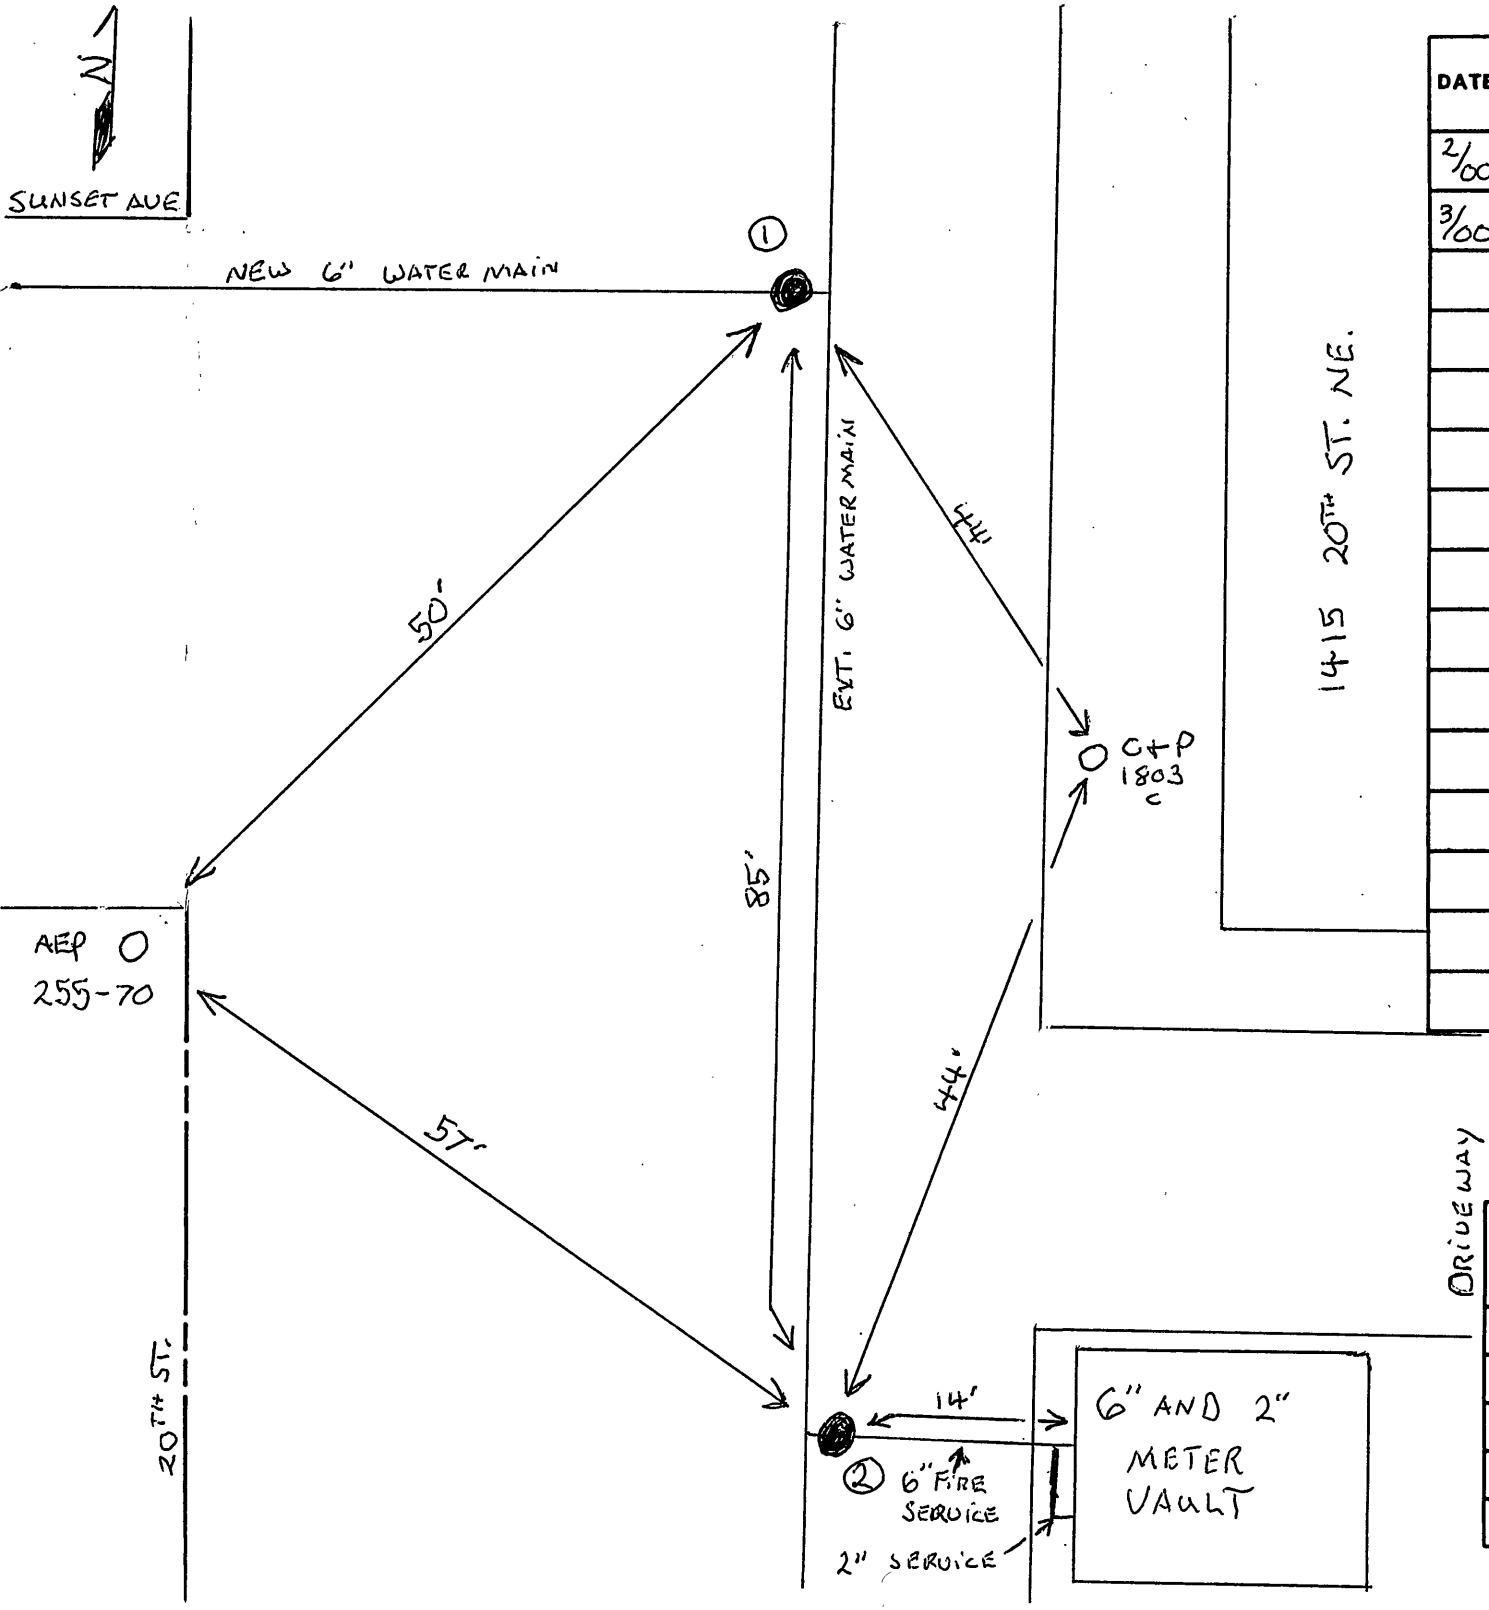

DATE	NO.	SIZE	MAKE	OPEN	TURNS
2/00	1	6"	MUELLER	R	21
3/00	2	6"	MUELLER	R	21

CITY OF ROANOKE - WATER DEP'T.

VALVE DIAGRAM

20TH ST. NE AND SUNSET AVE.

AT 1415 20TH ST. NE

SEC. MAP 322

DATE: 3-15-00 PAGE NO.