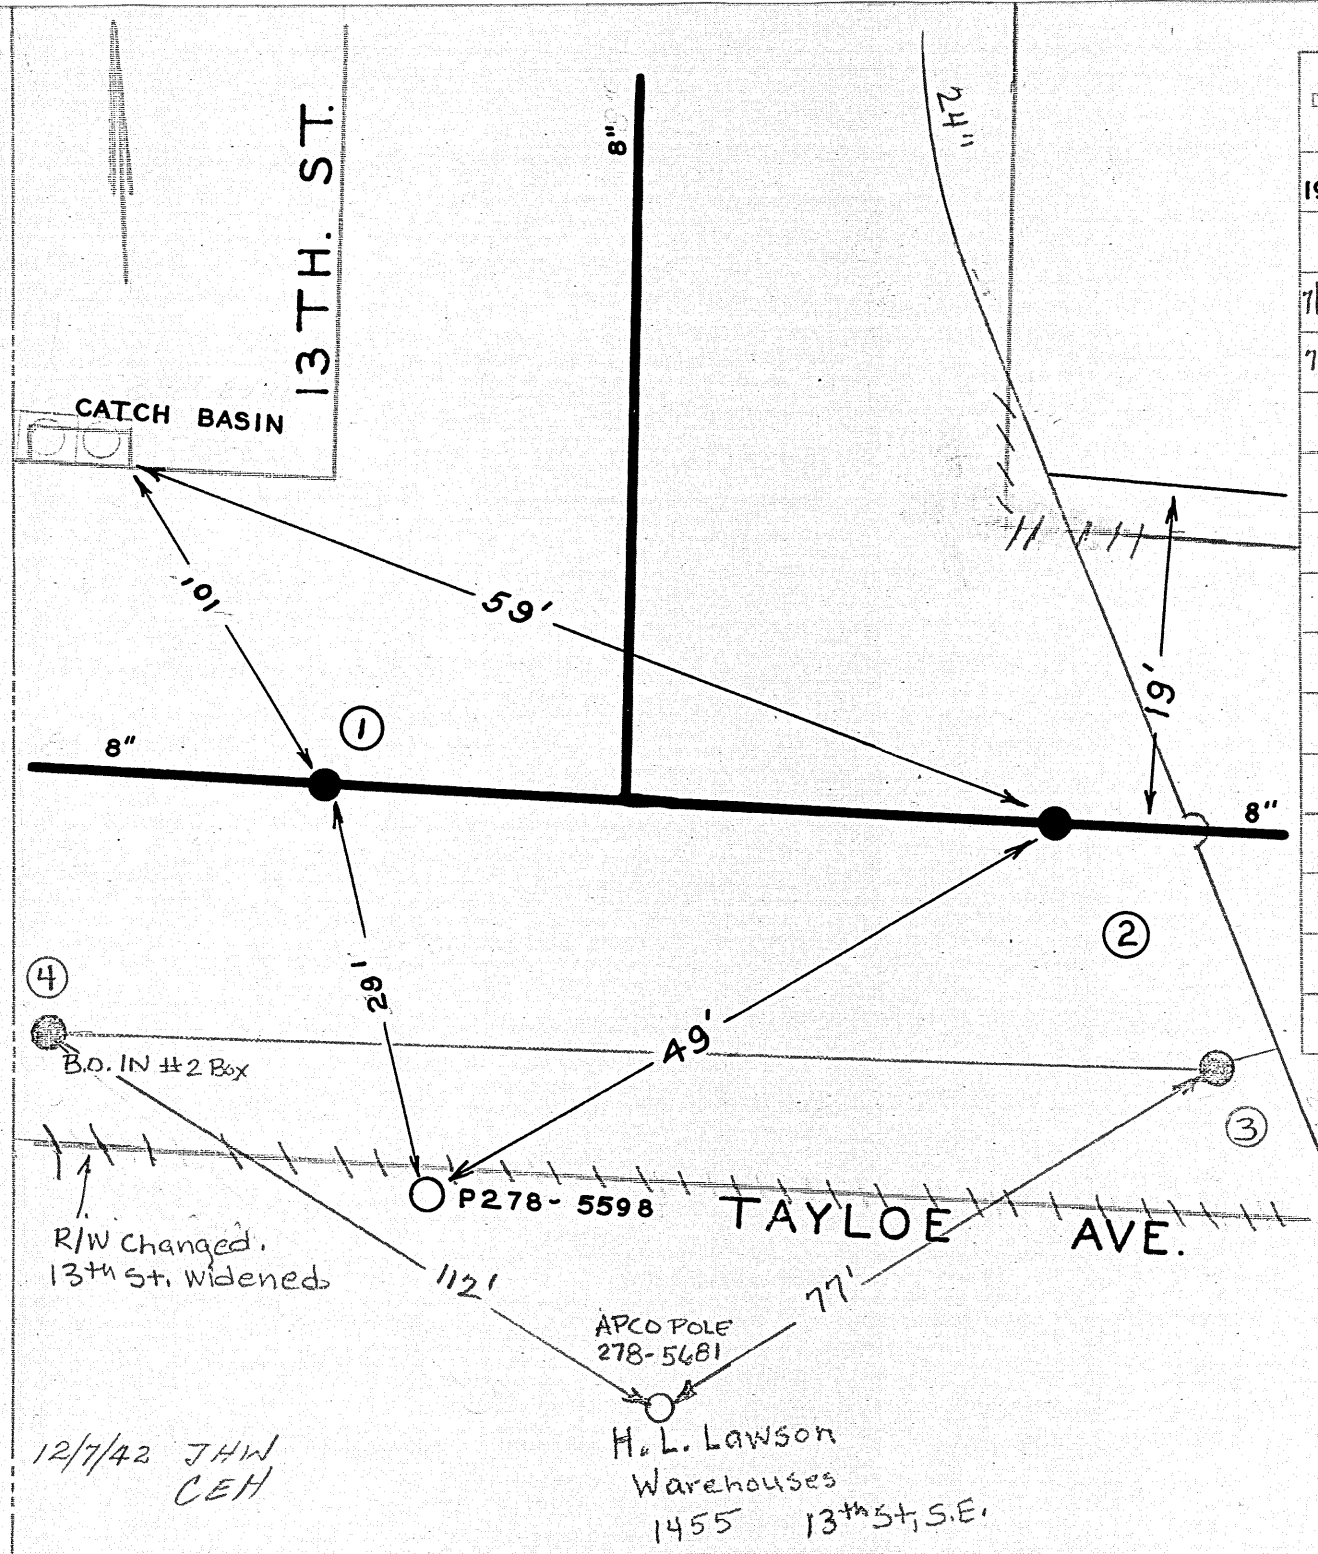

DATE	NO.	SIZE	MAKE	OPEN	TURNS
1930	1	8"		R	27 1/2
	2	8"			
7/1997	3	12"	Mueller	R	39
7/1997	4	2"	Misc	L	
	1	7'-W	WPL		
	2	0	EPL		

CITY OF ROANOKE—WATER DEP'T

VALVE DIAGRAM

TAYLOE AVE. & 13TH. ST. S. E.

SEC. MAP 423

DATE

PAGE NO S.E. 232