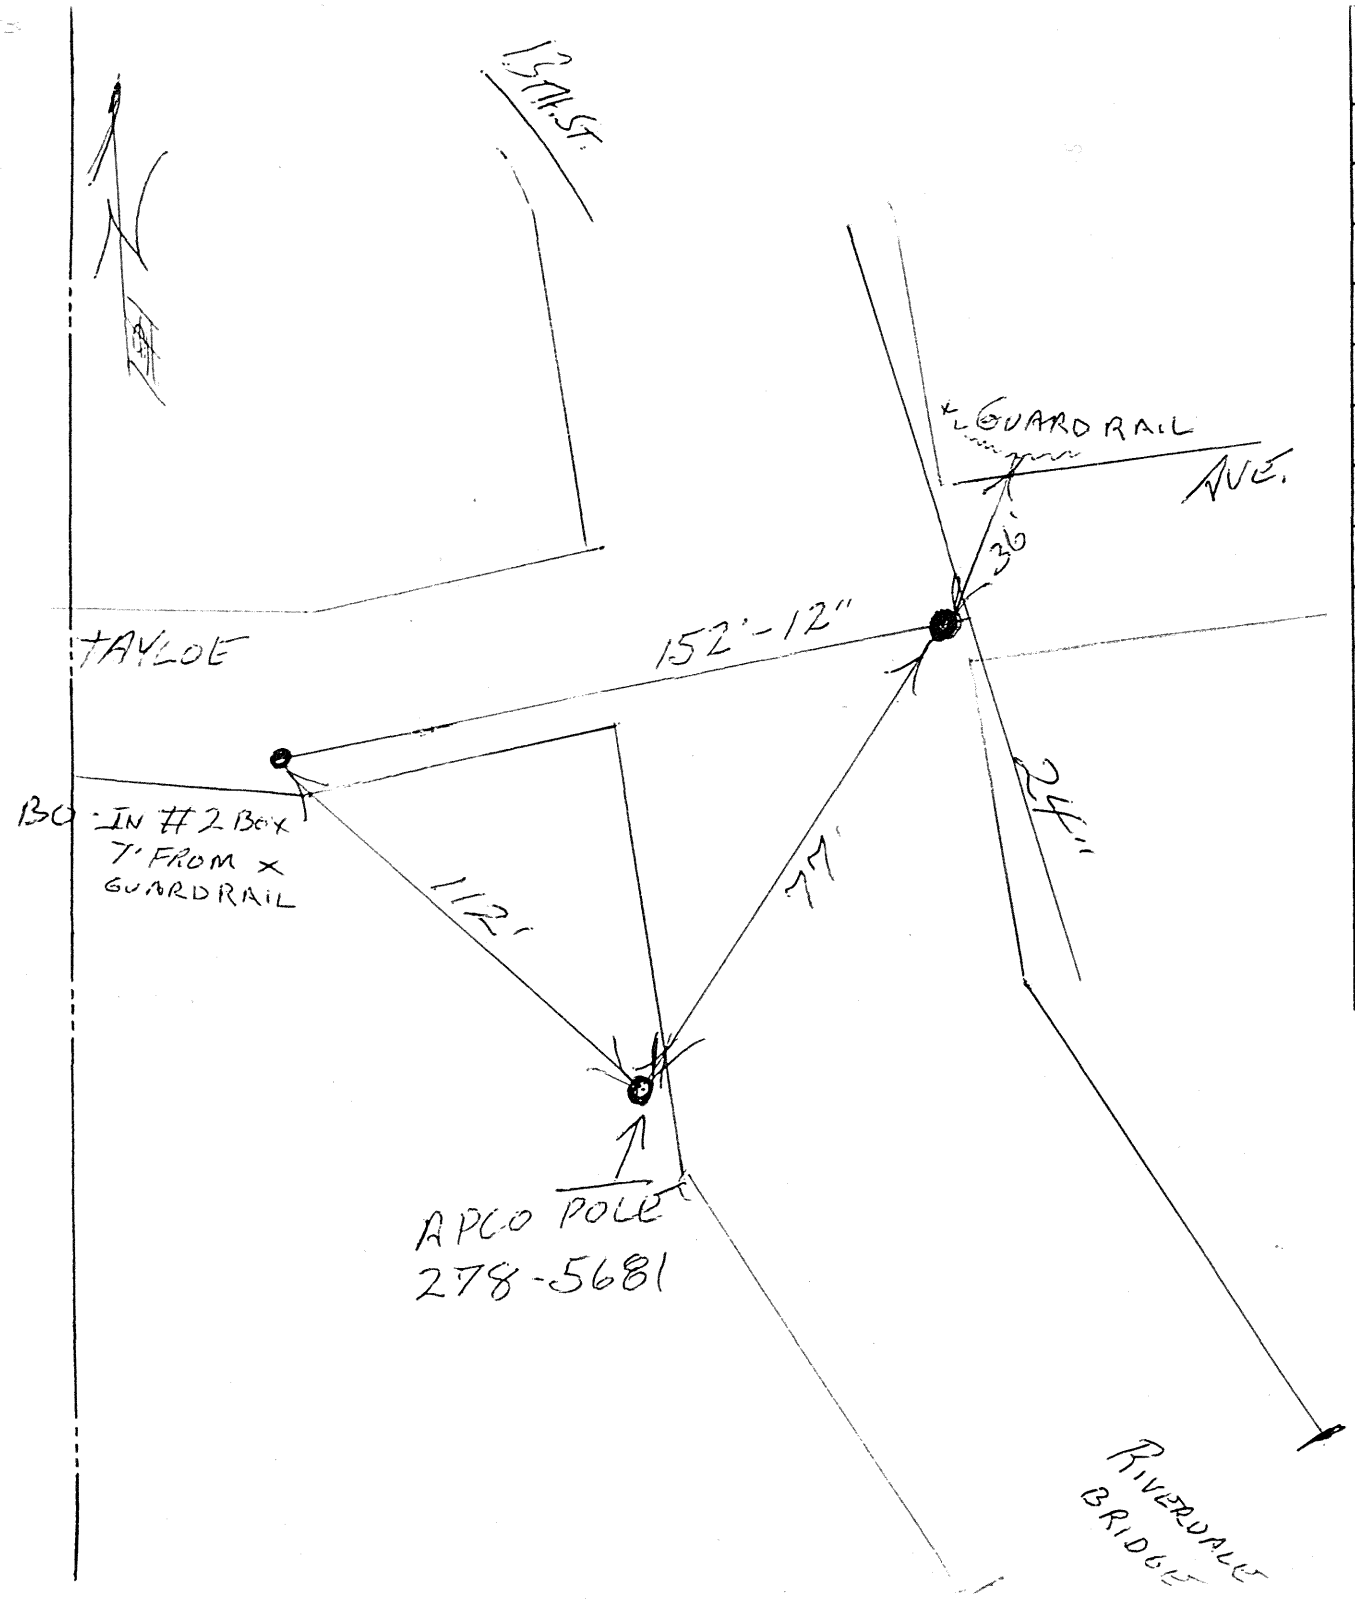


| DATE | NO. | SIZE | MAKE | OPEN | TURNS |
|---|---|---|---|---|---|
| 7-97 | 1 | 12 | M | R | 39 |
| 7-97 | 2 | 2" | MISC. | L | |
| | | | | | |
| | | | | | |
CITY OF ROANOKE—WATER DEP'T

**VALVE DIAGRAM**

TAYLOE AVE & 13TH ST. SE

SEC. MAP

DATE PAGE NO.