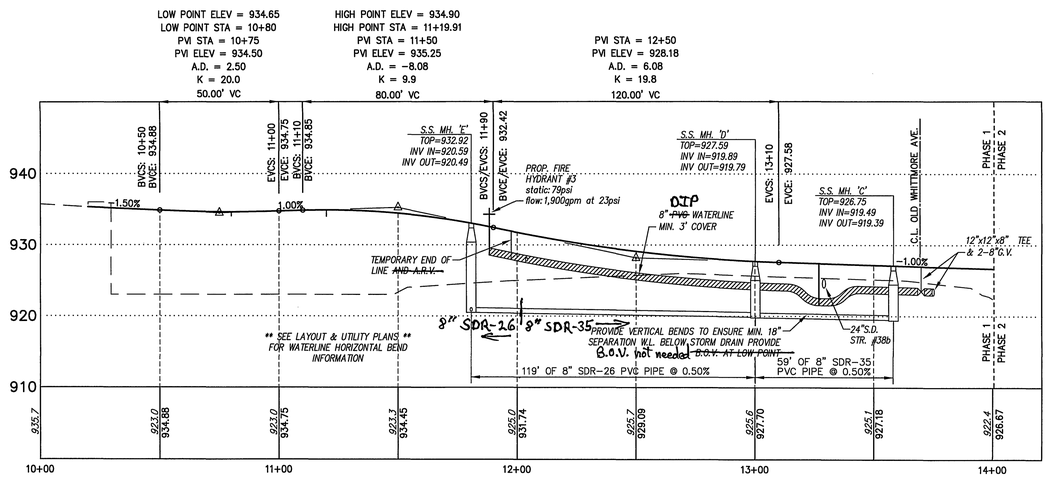

OLD WOODS AVENUE ROAD PROFILE:

1"=30' HORIZONTAL
1"=10' VERTICAL

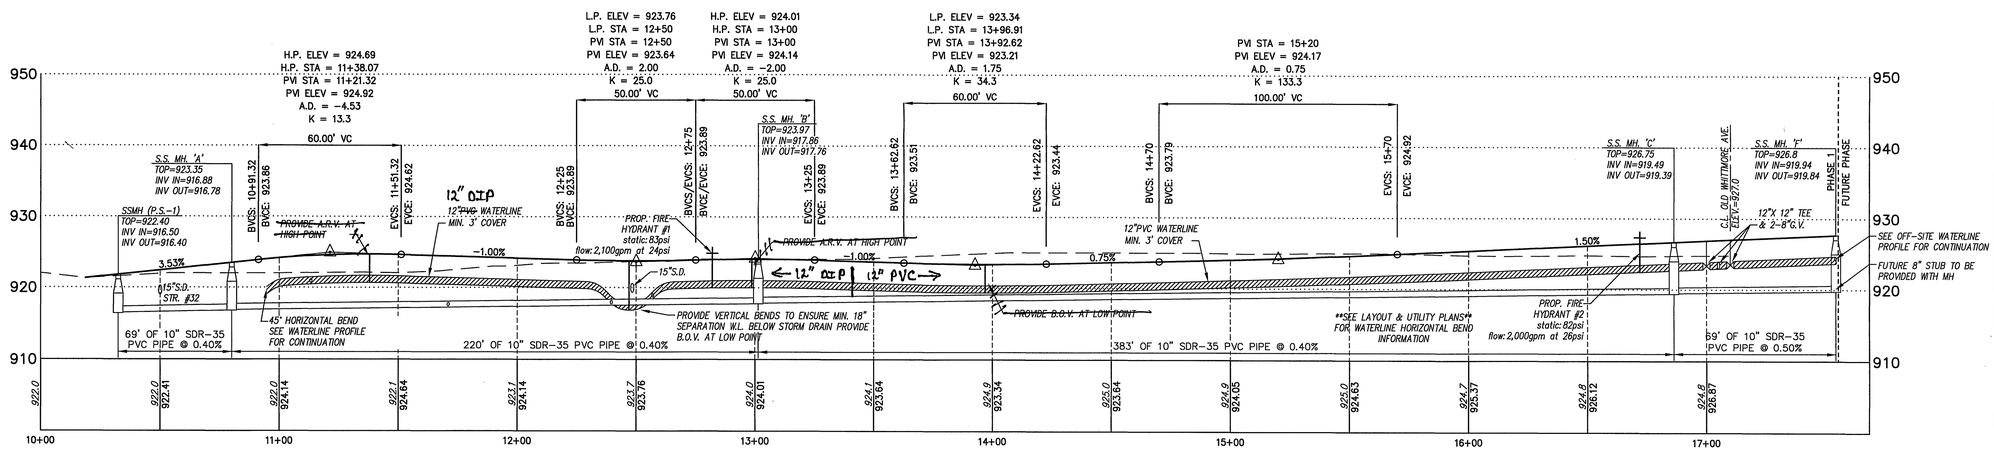

OLD WHITTMORE AVENUE ROAD PROFILE:

1"=30' HORIZONTAL
1"=10' VERTICAL

As-Built 3.10.15 K.Winslow

BALZER AND ASSOCIATES INC
REFLECTING TOMORROW
www.balzer.cc

New River Valley
Richmond
Roanoke
Shenandoah Valley

RESIDENTIAL LAND DEVELOPMENT ENGINEERING
SITE DEVELOPMENT ENGINEERING
LAND USE PLANNING & ZONING
LANDSCAPE ARCHITECTURE
LAND SURVEYING
ARCHITECTURE
STRUCTURAL ENGINEERING
TRANSPORTATION ENGINEERING
ENVIRONMENTAL & SOIL SCIENCE
WETLAND DELINEATIONS & STREAM EVALUATIONS

Balzer and Associates, Inc.
1208 Corporate Circle
Roanoke, VA 24018
540-772-9580
FAX 540-772-8050

COMMONWEALTH OF VIRGINIA
CHRISTOPHER P. BURNS
Lic. No.047338
1/30/14
PROFESSIONAL ENGINEER

ROANOKE RIVER DISTRICT - PHASE 1

ROAD PROFILES

CITY OF ROANOKE, VIRGINIA

DRAWN BY	BTC
DESIGNED BY	BTC
CHECKED BY	CPB
DATE	2-8-2013
SCALE	N/A

REVISIONS:
4-5-2013
4-19-2013
5-20-2013
10-24-2013 F.R. #1
1-30-2014 F.R. #2

APPROVED
APR 08 2014

SHEET NO.
C18

JOB NO. R1200033.01