



This document, together with the concepts and designs presented herein, is intended only for the specific purpose and client for which it was prepared. Reuse of and improper reliance on this document without written authorization and adaptation by Engineering Concepts, Inc. shall be without liability to Engineering Concepts, Inc.

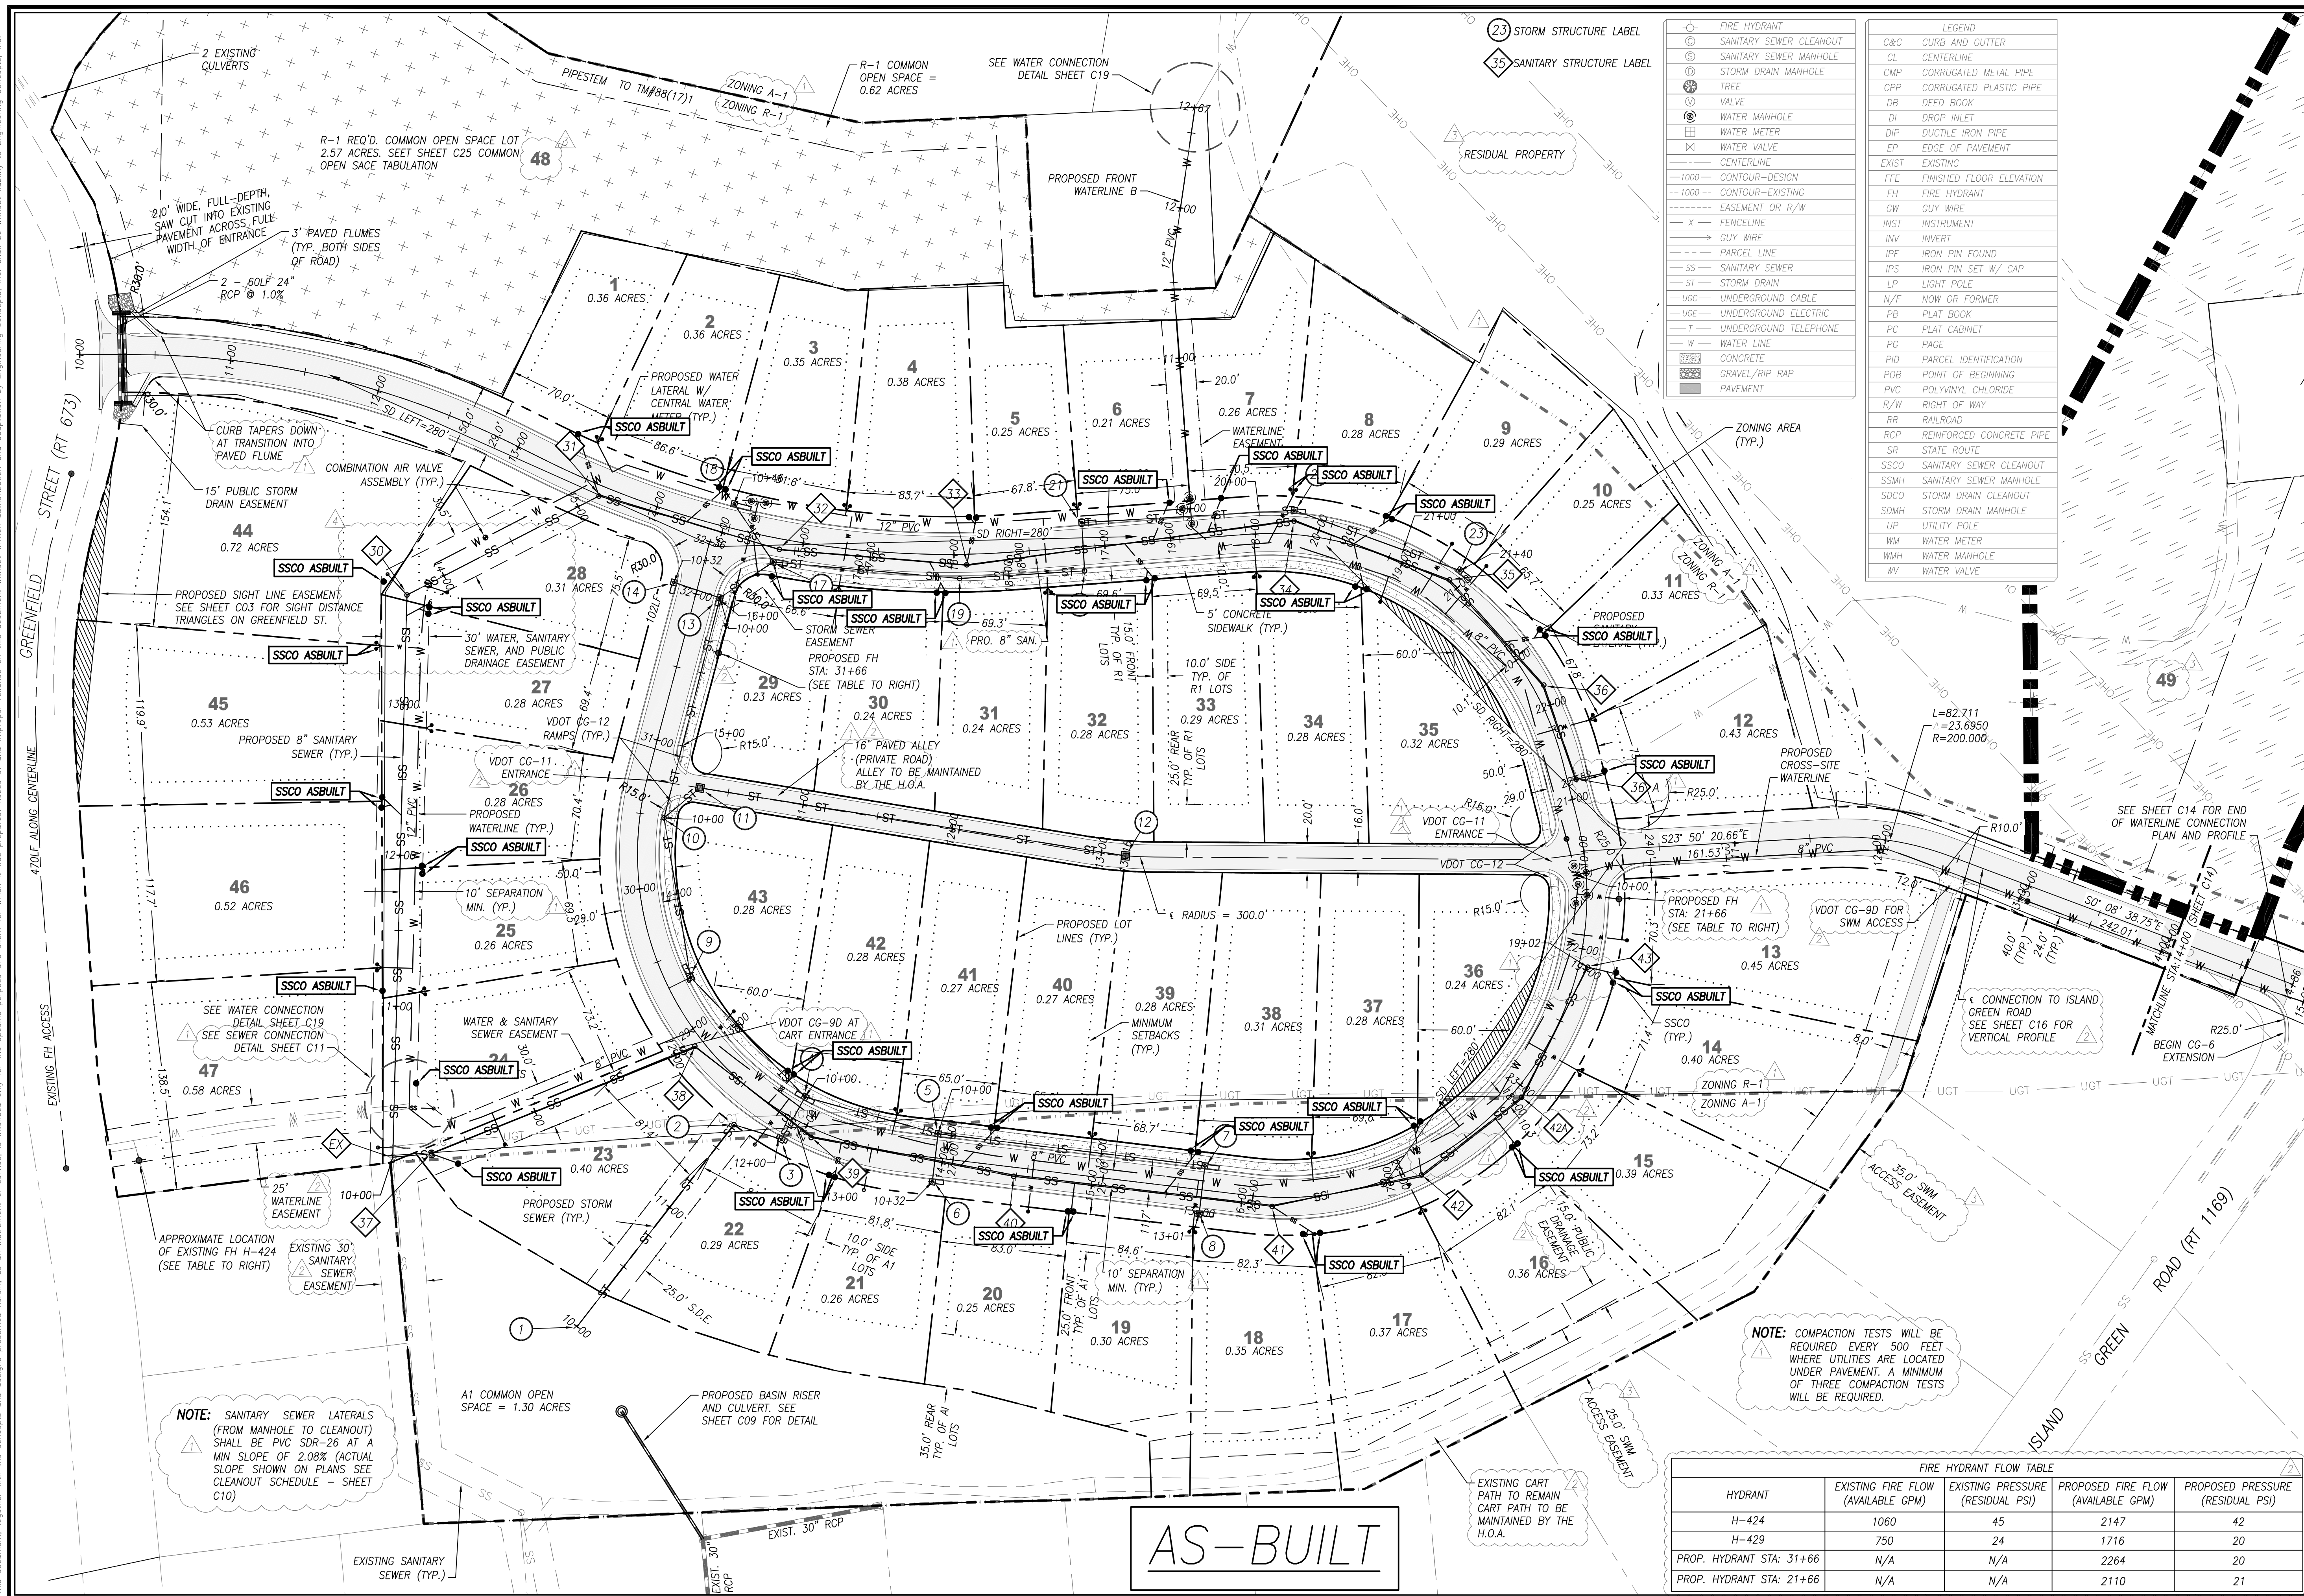

ENGINEERING CONCEPTS, INC.


94 GREENFIELD STREET
DALEVILLE, VIRGINIA 24083
540.473.1253

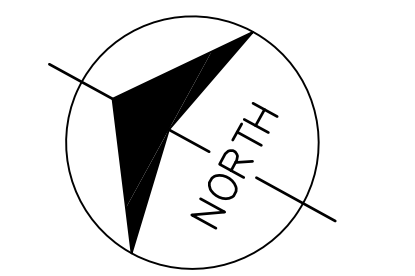

No.	Description	Date
1	1ST REVIEW COMMENTS	01/20/21
2	2ND REVIEW COMMENTS	05/04/21
3	3RD REVIEW COMMENTS	07/20/21
4	4TH REVIEW COMMENTS	08/17/21

PRESERVE AT ASHLEY BOTETOURT COUNTY

FRONT LOTS DEVELOPMENT SITE DIM. & UTILITY PLAN

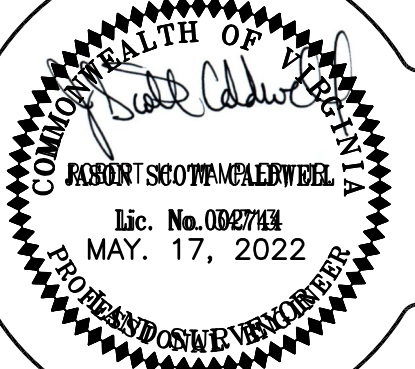

0	50	100
GRAPHIC SCALE		
PROJECT:	20004	
C04		