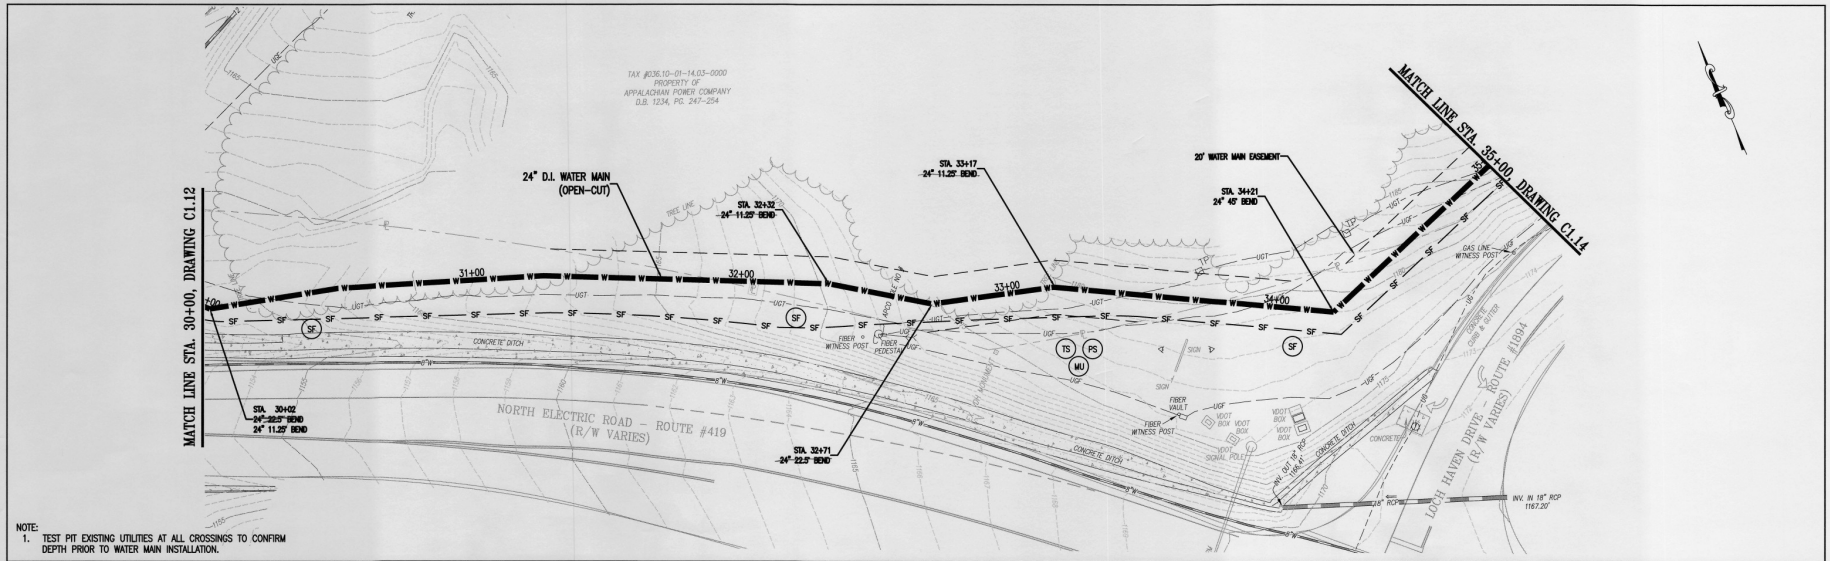

NOTE:
1. TEST PIT EXISTING UTILITIES AT ALL CROSSINGS TO CONFIRM DEPTH PRIOR TO WATER MAIN INSTALLATION.

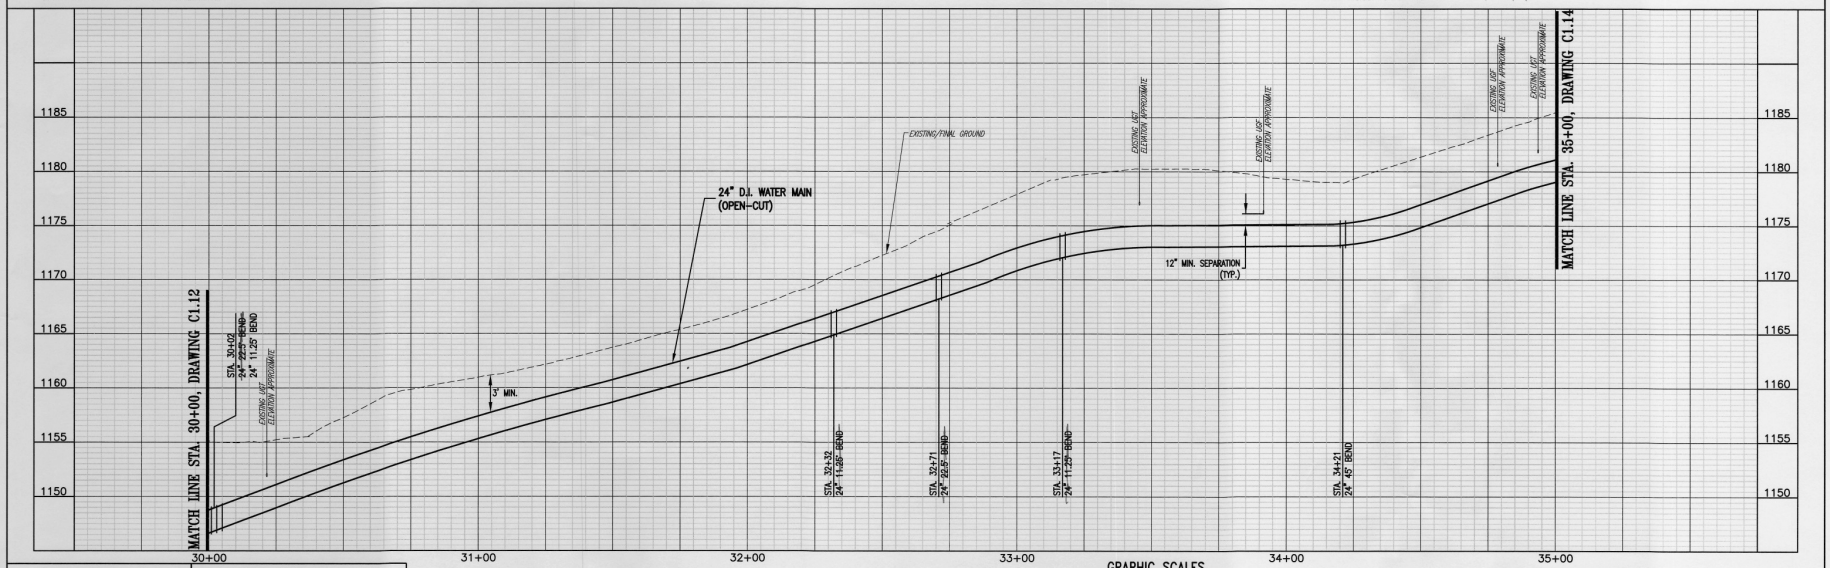

GRAPHIC SCALES

(IN FEET) HORIZ. 1 inch = 20 feet

(IN FEET) VERT: 1 inch = 5 feet

COMMONWEALTH OF VIRGINIA
PAULA J. MOORE
Lic. No. 035821
6/23/2022
PROFESSIONAL ENGINEER

WRA
Whitman, Requardt & Associates, LLP
1700 Kraft Dr, Suite 1200, Blacksburg, VA 24060

WESTERN VIRGINIA WATER AUTHORITY
601 South Jefferson Street, Suite 300
Roanoke, Virginia 24011

DES: BF	SCALE: AS SHOWN	
DRAWN: JES	HORIZ: 1" = 20'	
CHECK: PJM	VERT: 1" = 5'	
DATE: 6/23/22		

NORTH LOOP WATER MAIN EXTENSION
THOMPSON MEMORIAL DRIVE TO KESSLER MILL ROAD

24" WATER MAIN PLAN - PROFILE
STA. 30+00 TO STA. 35+00

REV	DATE	DESCRIPTION

DRAWING	SHEET
C1.13	13