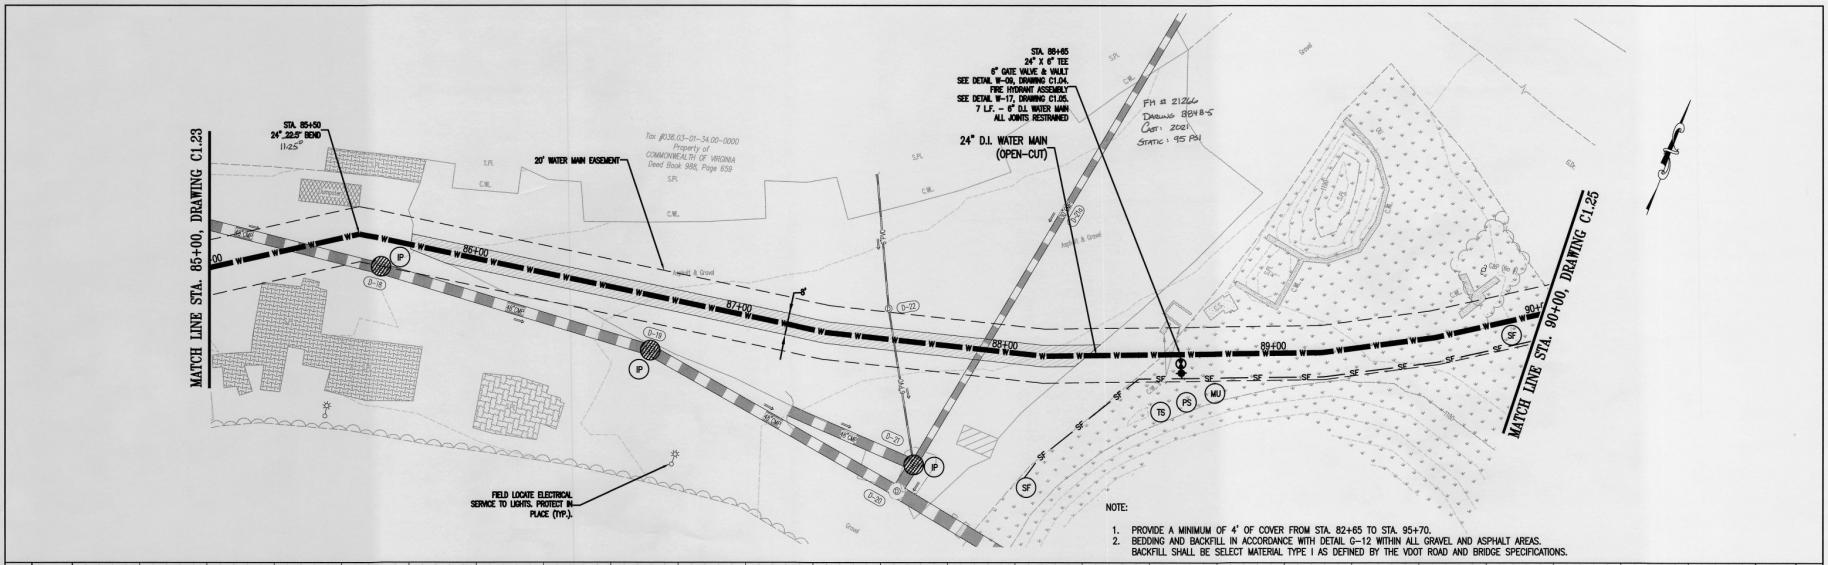

NOTE:

1. PROVIDE A MINIMUM OF 4' OF COVER FROM STA. 82+65 TO STA. 95+70.
2. BEDDING AND BACKFILL IN ACCORDANCE WITH DETAIL G-12 WITHIN ALL GRAVEL AND ASPHALT AREAS. BACKFILL SHALL BE SELECT MATERIAL TYPE I AS DEFINED BY THE VDOT ROAD AND BRIDGE SPECIFICATIONS.

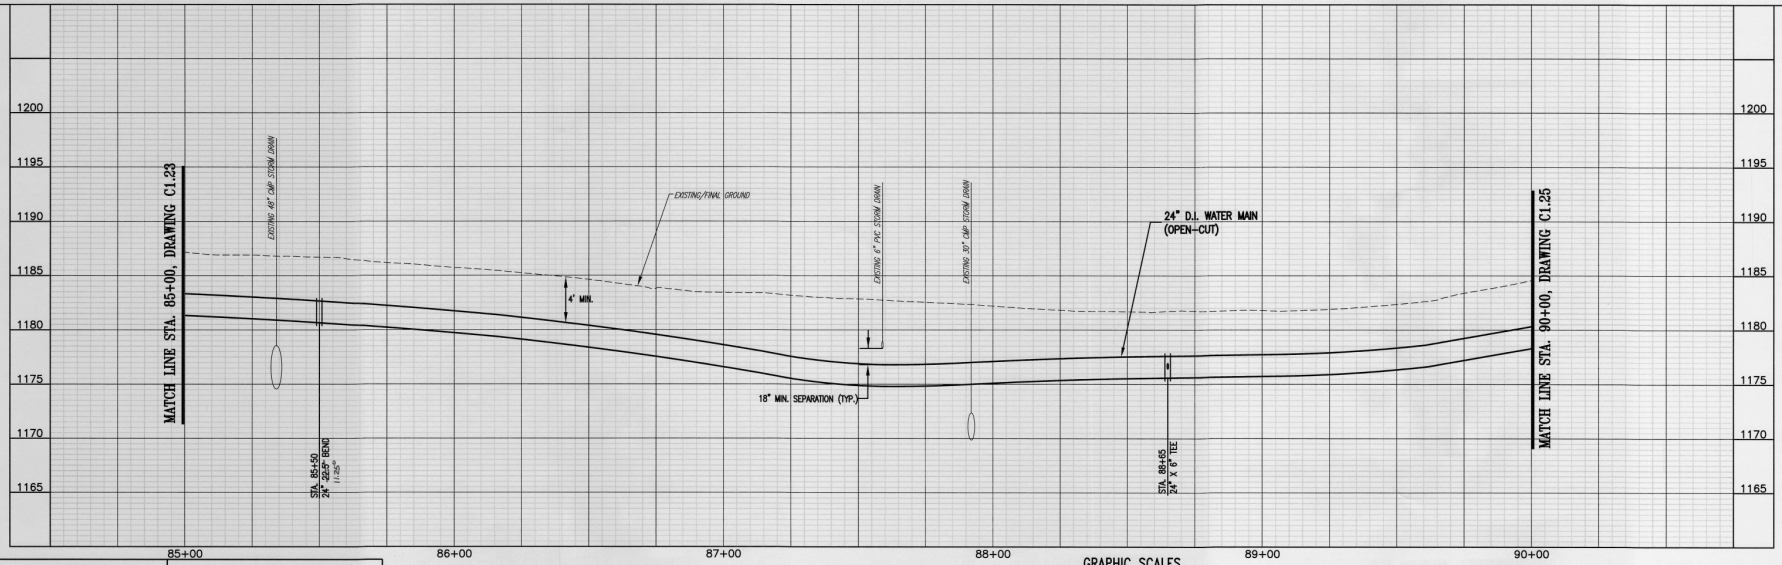

GRAPHIC SCALES

(IN FEET)
HORIZ. 1 inch = 20 feet

(IN FEET)
VERT: 1 inch = 5 feet

COMMONWEALTH OF VIRGINIA
PAULA J. MOORE
Lic. No. 035821
6/23/2022
PROFESSIONAL ENGINEER

WRA
Whitman, Requardt & Associates, LLP
1700 Kraft Dr, Suite 1200, Blacksburg, VA 24060

WESTERN VIRGINIA WATER AUTHORITY
601 South Jefferson Street, Suite 300
Roanoke, Virginia 24011

DES: BF	SCALE: AS SHOWN
DRAWN: JES	HORIZ: 1" = 20'
CHECK: PJM	VERT: 1" = 5'
DATE: 6/23/22	

NORTH LOOP WATER MAIN EXTENSION
THOMPSON MEMORIAL DRIVE TO KESSLER MILL ROAD

24" WATER MAIN PLAN - PROFILE
STA. 85+00 TO STA. 90+00

REV	DATE	DESCRIPTION

DRAWING	SHEET
C1.24	24