AS-BUILT

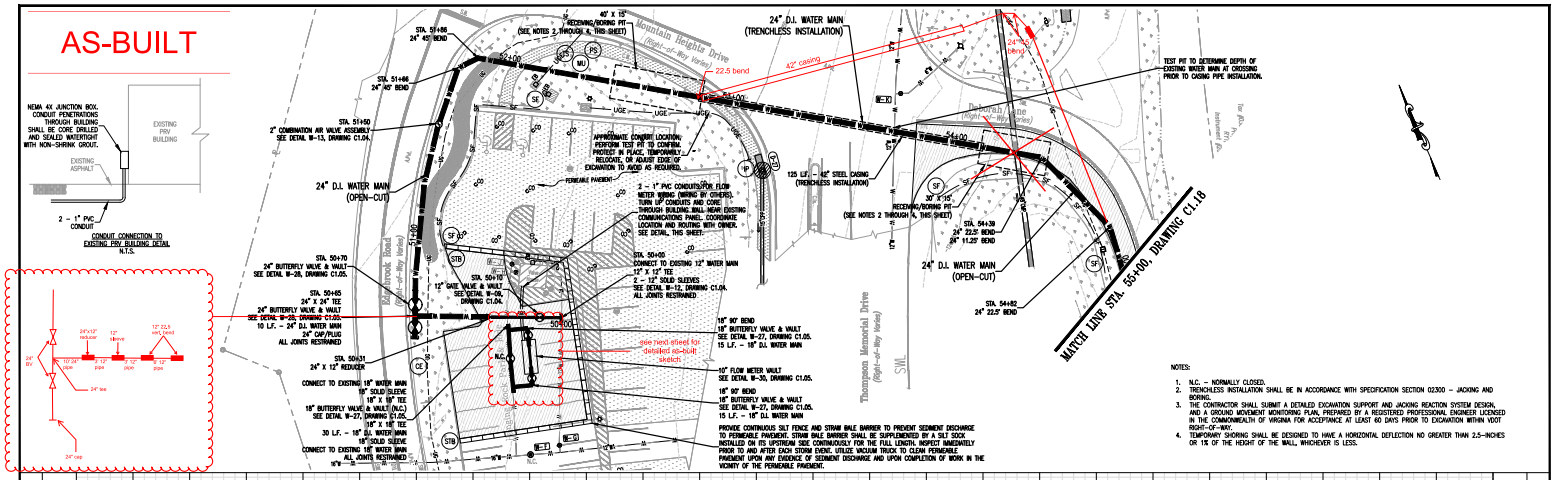

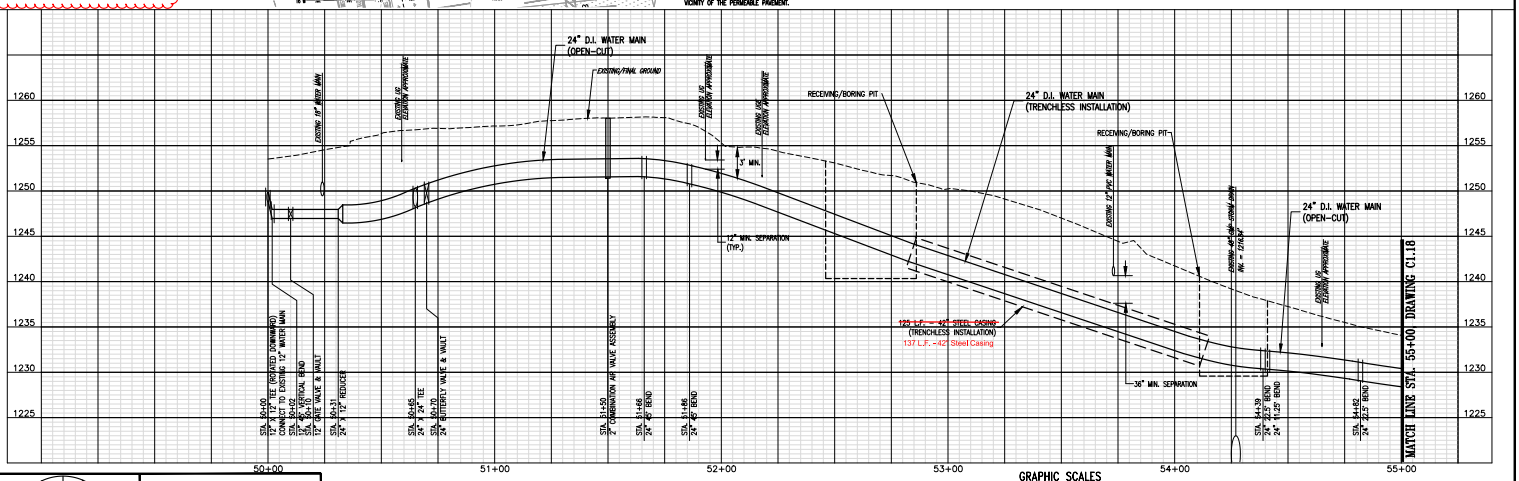

GRAPHIC SCALES

(IN FEET) HORIZ. 1 inch = 20 feet

(IN FEET) VERT. 1 inch = 5 feet

Contractor's Certification

12/15/2023

Whitman, Requardt & Associates, LLP
1700 Kraft Dr, Suite 1200, Blacksburg, VA 24060

WESTERN VIRGINIA WATER AUTHORITY
601 South Jefferson Street, Suite 300
Roanoke, Virginia 24011

DES: BIF	SCALE: AS SHOWN	
DRAWN: JBS	HORIZ: 1" = 20'	
CHECK: PJH	VERT: 1" = 5'	
DATE: 6/23/22		

NORTH LOOP WATER MAIN EXTENSION
THOMPSON MEMORIAL DRIVE TO KESSLER MILL ROAD

24" WATER MAIN PLAN - PROFILE
STA. 50+00 TO STA. 55+00

REV	DATE	DESCRIPTION

DRAWING	SHEET
C1.17	17