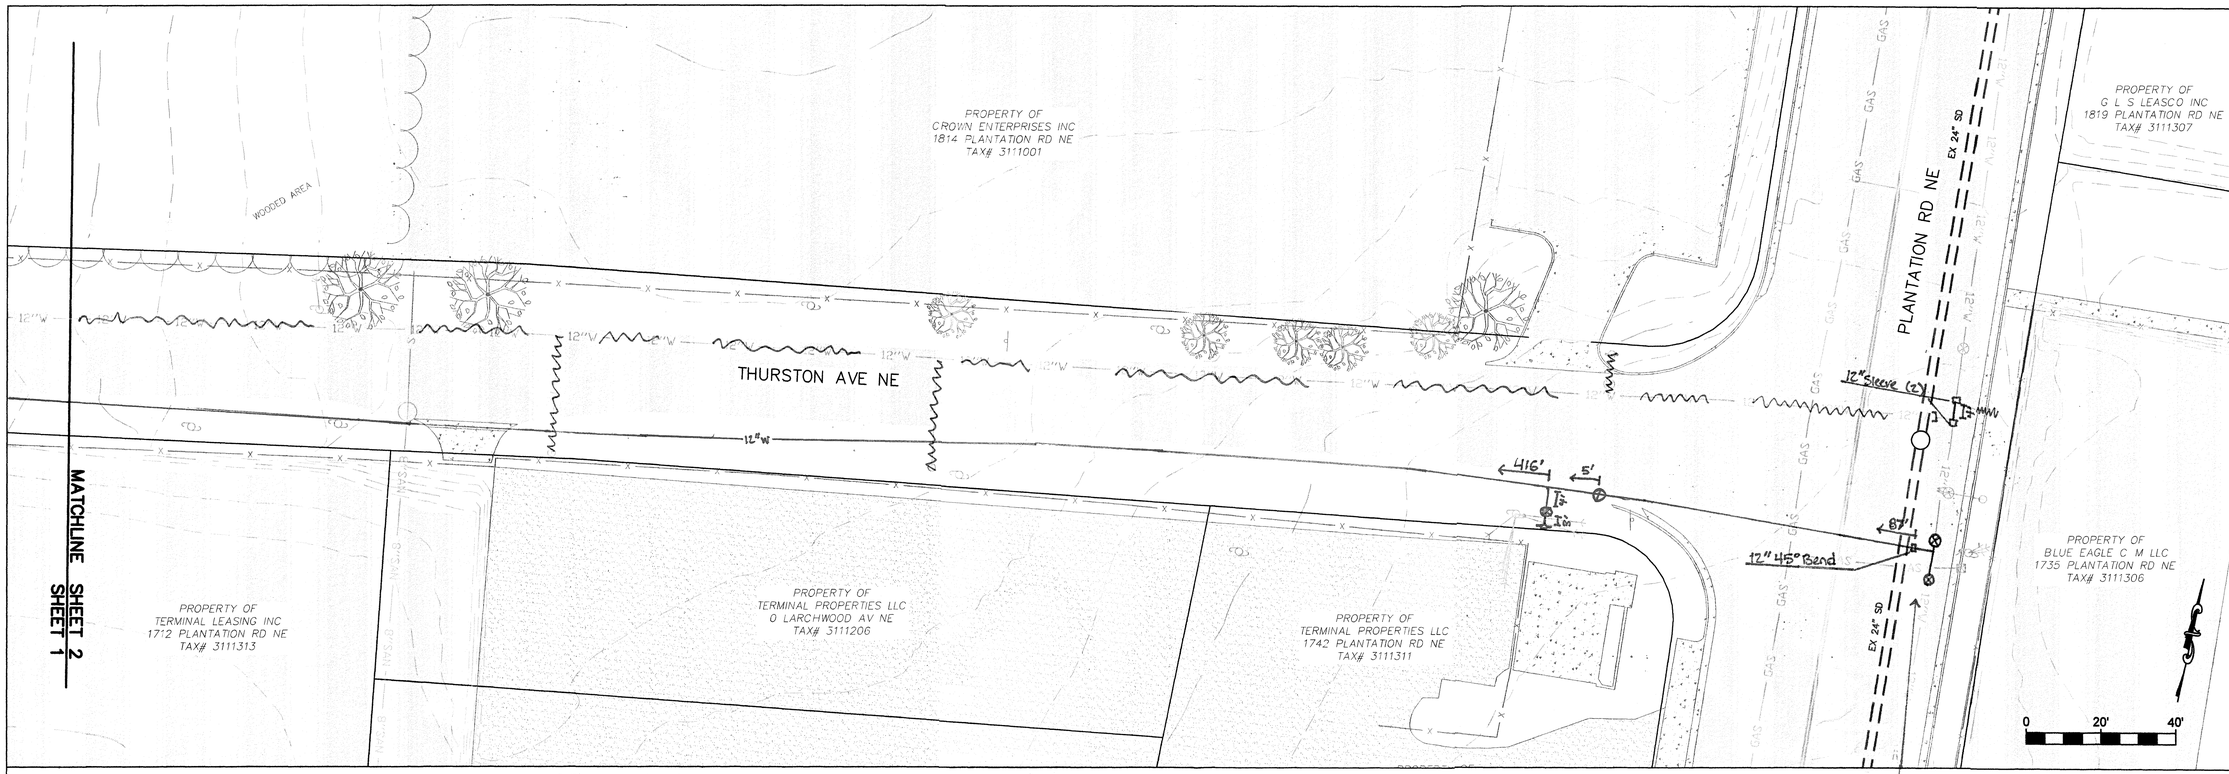

Install Contractor		
Construction Start Date		
Completion Date		
	Water Main(s)	
Manufacturer		
Diameter		
Pipe Class		
Material		
Comments		
	Water Service(s)	
Manufacturer		
Diameter		
Pipe Class		
Material		
Comments		
	Water Valve(s) 1	**Water Valve(s) 2**
Manufacturer		
Valve Type		
Diameter		
Direction to Open / Turns to Close		
Comments		
	Water Valve (s) 3	**Water Valve (s) 4**
Manufacturer		
Valve Type		
Diameter		
Direction to Close / Turns to Close		
Comments		
	Hydrant(s)	
Authority ID #		
Manufacturer		
Model		
Cast Date		
Static Pressure		
Comments		

GENERAL NOTES:
1. SEWER LATERALS SHOWN ARE BASED ON CCTV FOOTAGE. ADDITIONAL LATERALS & CONFLICTS SHALL BE INVESTIGATED BY CONTRACTOR PRIOR TO EXCAVATION.
2. PROPERTY LINES SHOWN ON THIS PAGE ARE BASED ON GIS DATA AND HAVE NOT BEEN FIELD SURVEYED.
3. ALL INSTALLATIONS WILL BE IN ACCORDANCE TO REGIONAL DESIGN & CONSTRUCTION STANDARDS.

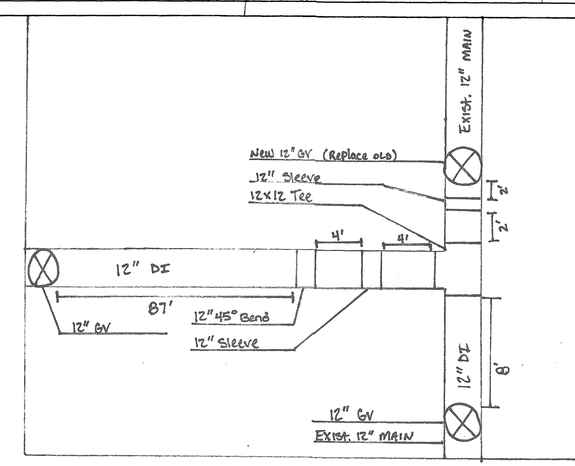

WATER AUTHORITY
ENGINEERING SERVICES
601 S JEFFERSON ST, SUITE 300
ROANOKE, VA 24011
540-853-5700

PRELIMINARY
NOT FOR CONSTRUCTION

THURSTON AVE NE 12"
WATERLINE REPLACEMENT
BASEMAP

REV	DESCRIPTION	DATE	BY
1	Construction Completed	11/12/24	RC
2	Redline	11/14/24	RC

Designed: ~~WWA~~ RC
Drawn: NSS
Checked: AJC
Approved:
Date: FY-25 PAVING
Project: WCIP-459

2
Sheet 2 of 2