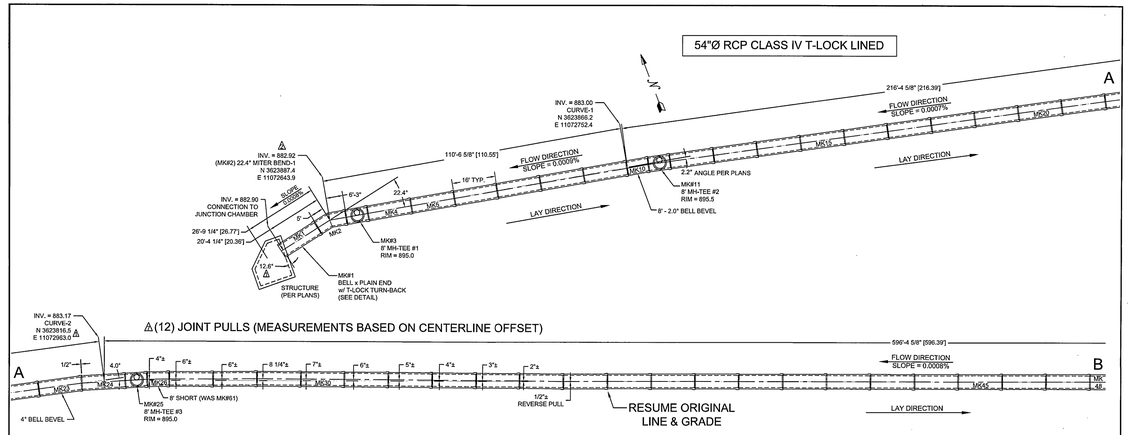

1. REVISIONS 2/14/13
2. REVISIONS 3/05/13
3. REVISIONS 5/07/13
4. JOINT PULLS 9/09/13
5. 54"x42" ADAPTORS 10/01/13
6. 54"x42" ADJUSTMENTS 11/01/13
7. AS BUILT ADJUSTMENTS

THIS LAYOUT PROVIDED AS A GUIDE FOR DISTRIBUTION AND INSTALLATION.
FIELD ADJUSTMENTS MUST BE MADE AS NECESSARY.

CONTRACTOR TO VERIFY ELEVATIONS, LENGTHS AND DIMENSIONS

REDUCED SCALE

TINKER CREEK PARALLEL RELIEF SEWER
54" RCP T-LOCK SEWER PIPE LAYOUT
WESTERN VIRGINIA WATER AUTHORITY - ROANOKE, VA
ALLEGHENY CONSTRUCTION CO., INC

CP&P
CONCRETE PIPE & PRECAST, LLC

RSP	02/01/13
REVISED	1 02/14/13
REVISED	2 03/05/13
REVISED	3 05/07/13
REVISED	4 09/09/13 5 10/02/13
REVISED	6 11/01/13 7 01/27/14

13006 LAYOUT 1 OF 2

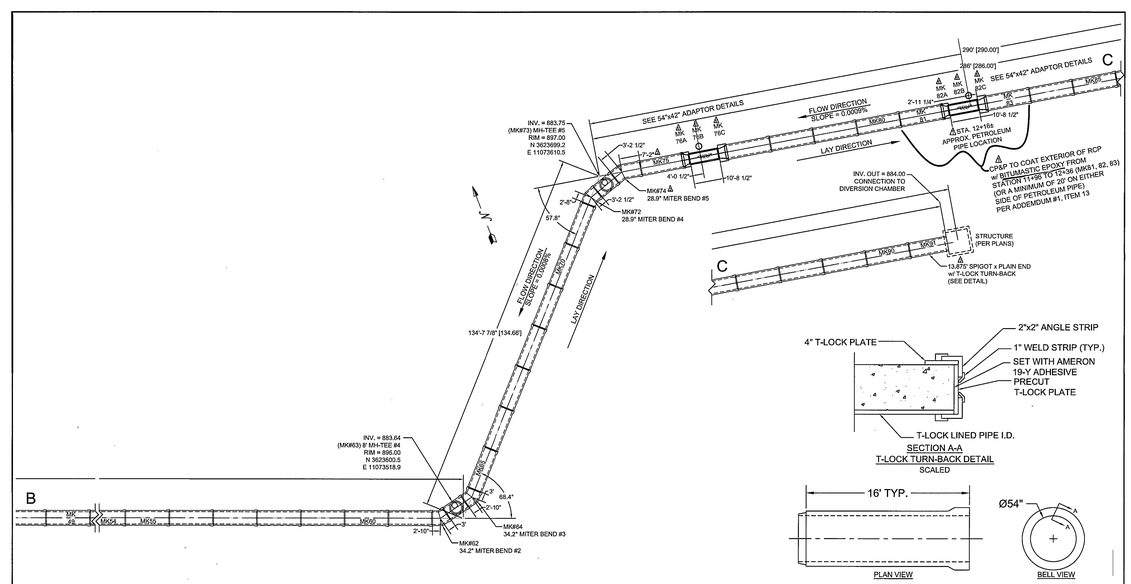

7. 01-27-14 NO KNOWN ADDITIONAL AS BUILT ADJUSTMENTS NEEDED

THIS LAYOUT PROVIDED AS A GUIDE FOR DISTRIBUTION AND INSTALLATION.
FIELD ADJUSTMENTS MUST BE MADE AS NECESSARY.

CONTRACTOR TO VERIFY ELEVATIONS, LENGTHS AND DIMENSIONS

1. REVISIONS 2/14/13
2. REVISIONS 3/05/13
3. REVISIONS 5/07/13
4. JOINT PULLS 9/09/13
5. 54"x42" ADAPTORS 10/01/13
6. 54"x42" ADJUSTMENTS 11/01/13

REDUCED SCALE

TINKER CREEK PARALLEL RELIEF SEWER
54" RCP T-LOCK SEWER PIPE LAYOUT
WESTERN VIRGINIA WATER AUTHORITY - ROANOKE, VA
ALLEGHENY CONSTRUCTION CO., INC

CP&P
CONCRETE PIPE & PRECAST, LLC

RSP	02/01/13
REVISED	1 02/14/13
REVISED	2 03/05/13
REVISED	3 05/07/13
REVISED	4 09/09/13
REVISED	5 10/02/13 6 11/01/13

13006 LAYOUT 2 OF 2

G-2 A

SHEET 2 OF