


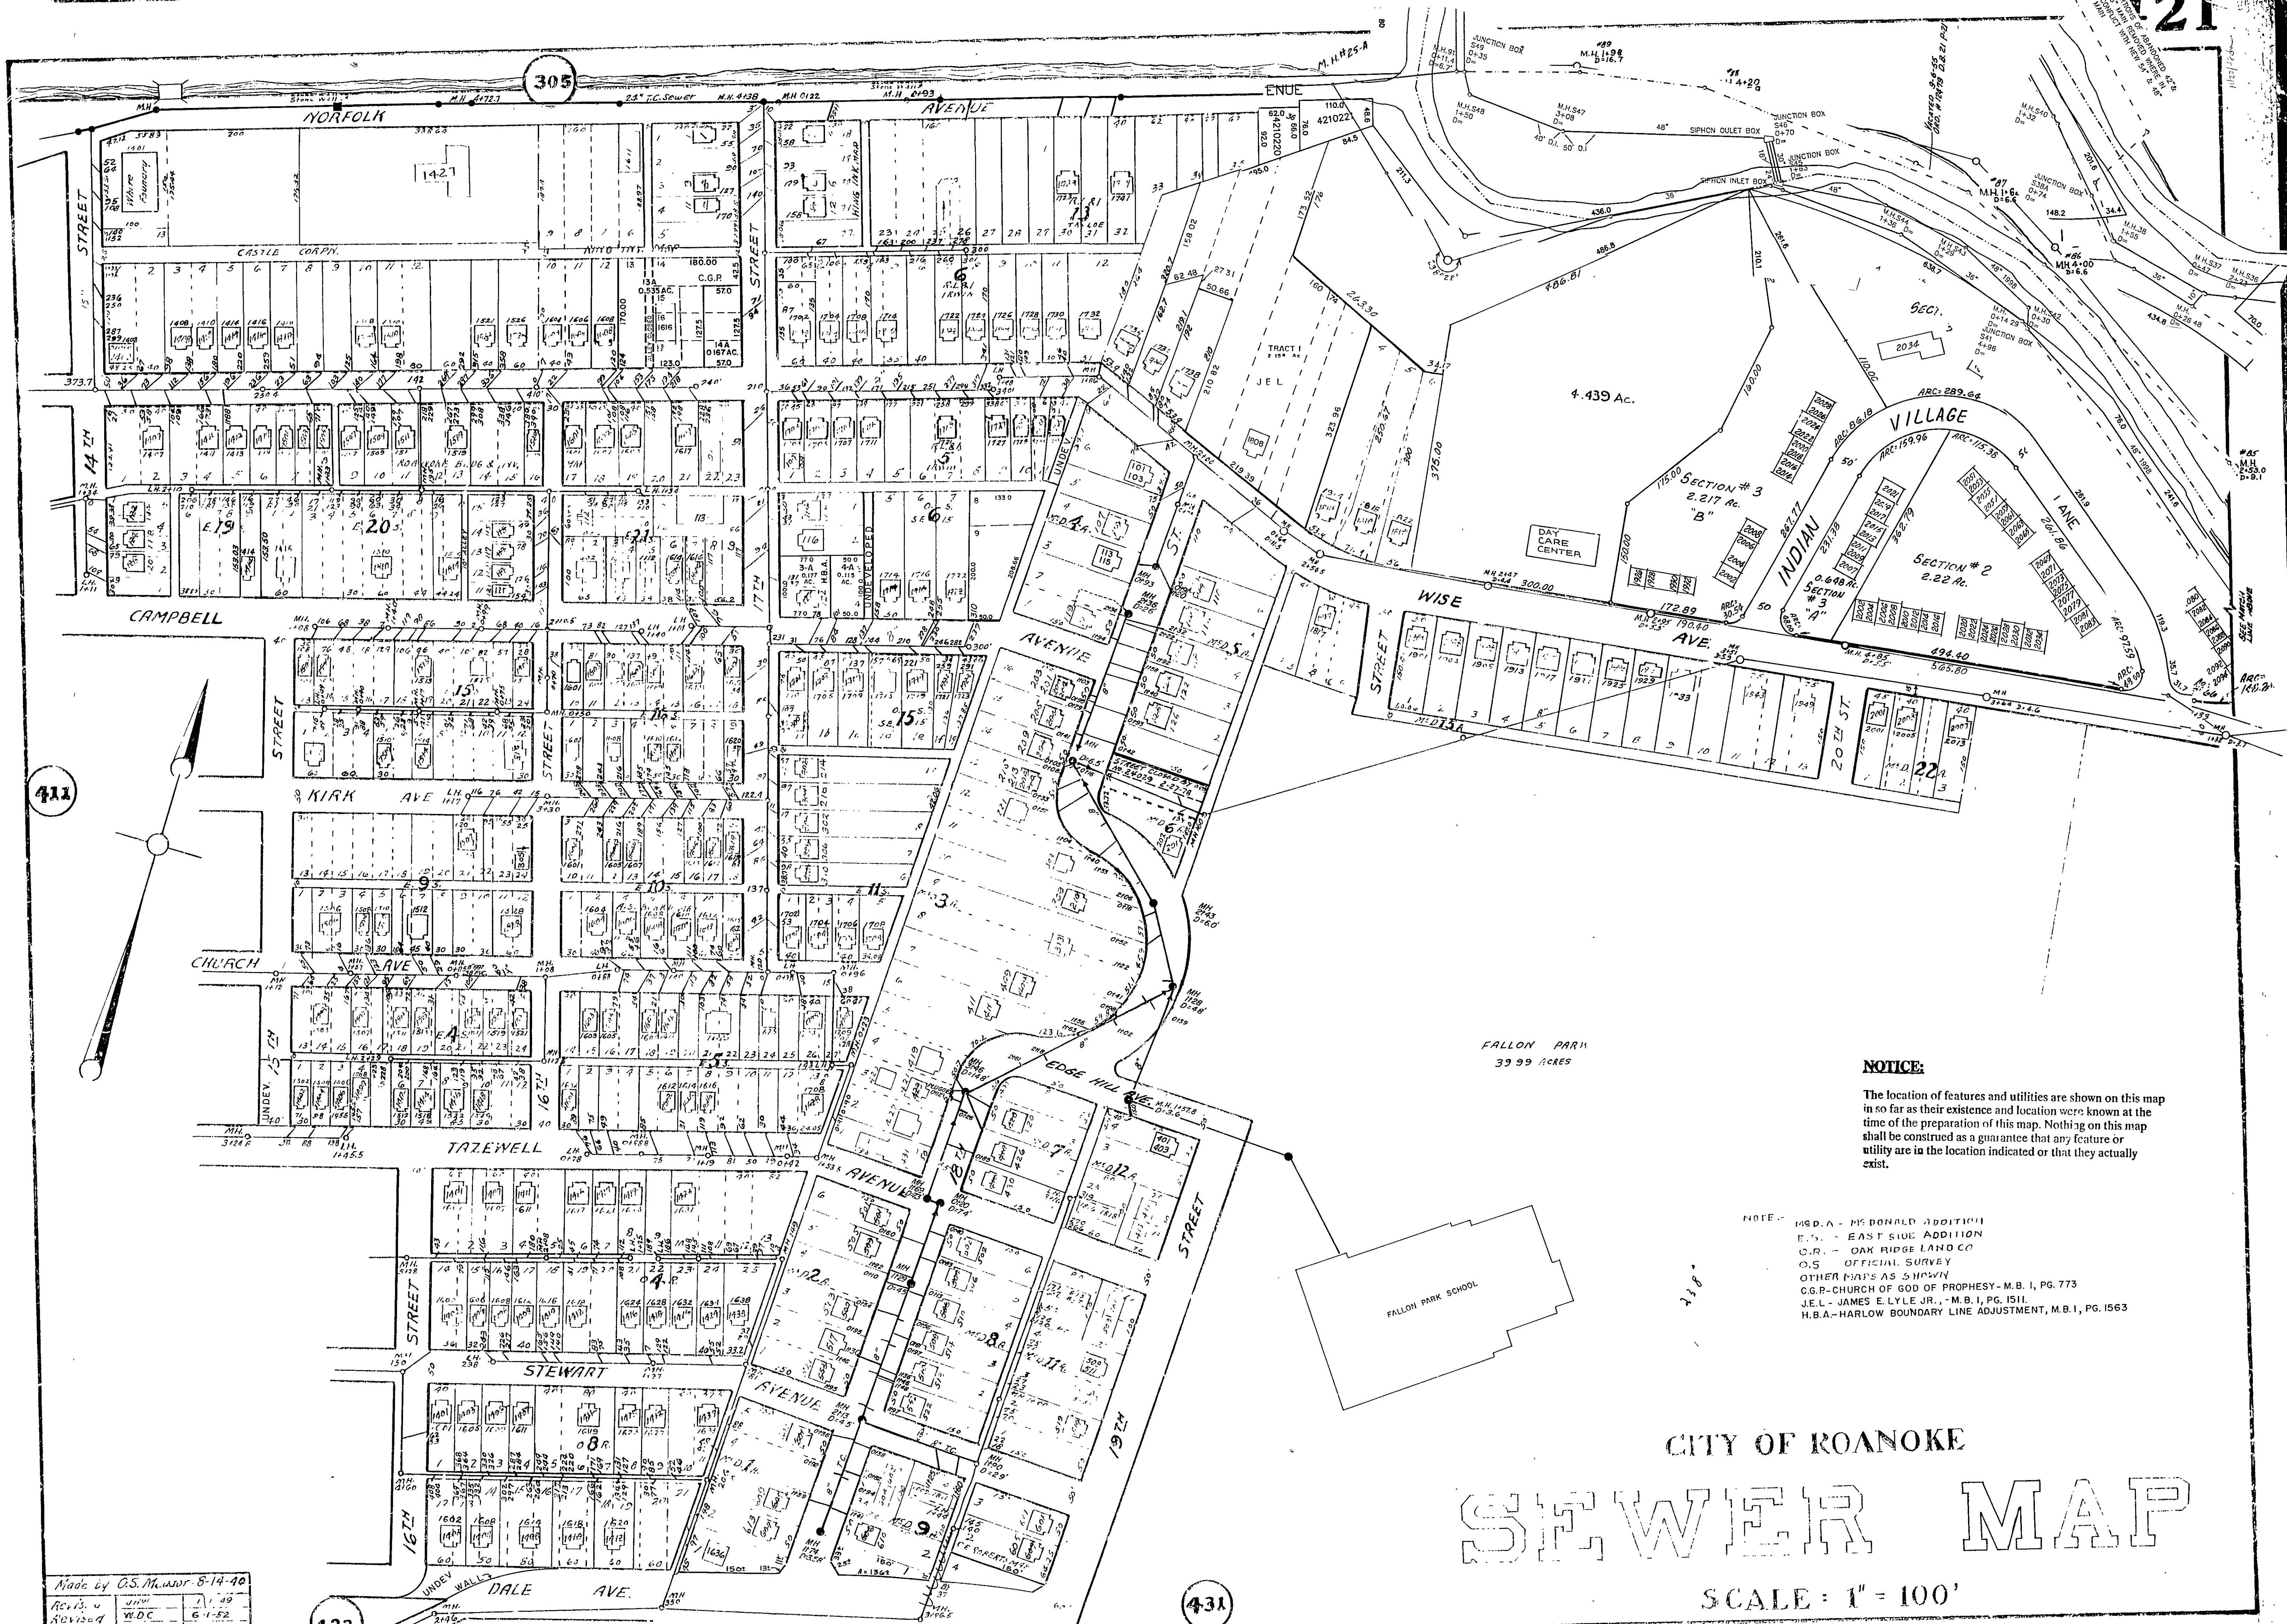

NOTICE:
The location of features and utilities are shown on this map in so far as their existence and location were known at the time of the preparation of this map. Nothing on this map shall be construed as a guarantee that any feature or utility are in the location indicated or that they actually exist.

NOTE - M.S.D.A. - Mc DONALD ADDITION
E.S.A. - EAST SIDE ADDITION
O.R. - OAK RIDGE LAND CO.
O.S. - OFFICIAL SURVEY
OTHER MAPS AS SHOWN
C.G.P. - CHURCH OF GOD OF PROPHECY - M.B. I, PG. 773
J.E.L. - JAMES E. LYLE JR. - M.B. I, PG. 1511
H.B.A. - HARLOW BOUNDARY LINE ADJUSTMENT, M.B. I, PG. 1563

CITY OF ROANOKE SEWER MAP

SCALE : 1" = 100'

Made by O.S. Minor 8-14-40
Revised W.D.C. 1-1-49
Revised 6-1-52