


PLAN	SURVEYED	DATE
	PLOTTED	BY
NO.	NOTE BOOK	ALIGNMENT CHECKED
	NO.	RT. OF WAY CHECKED

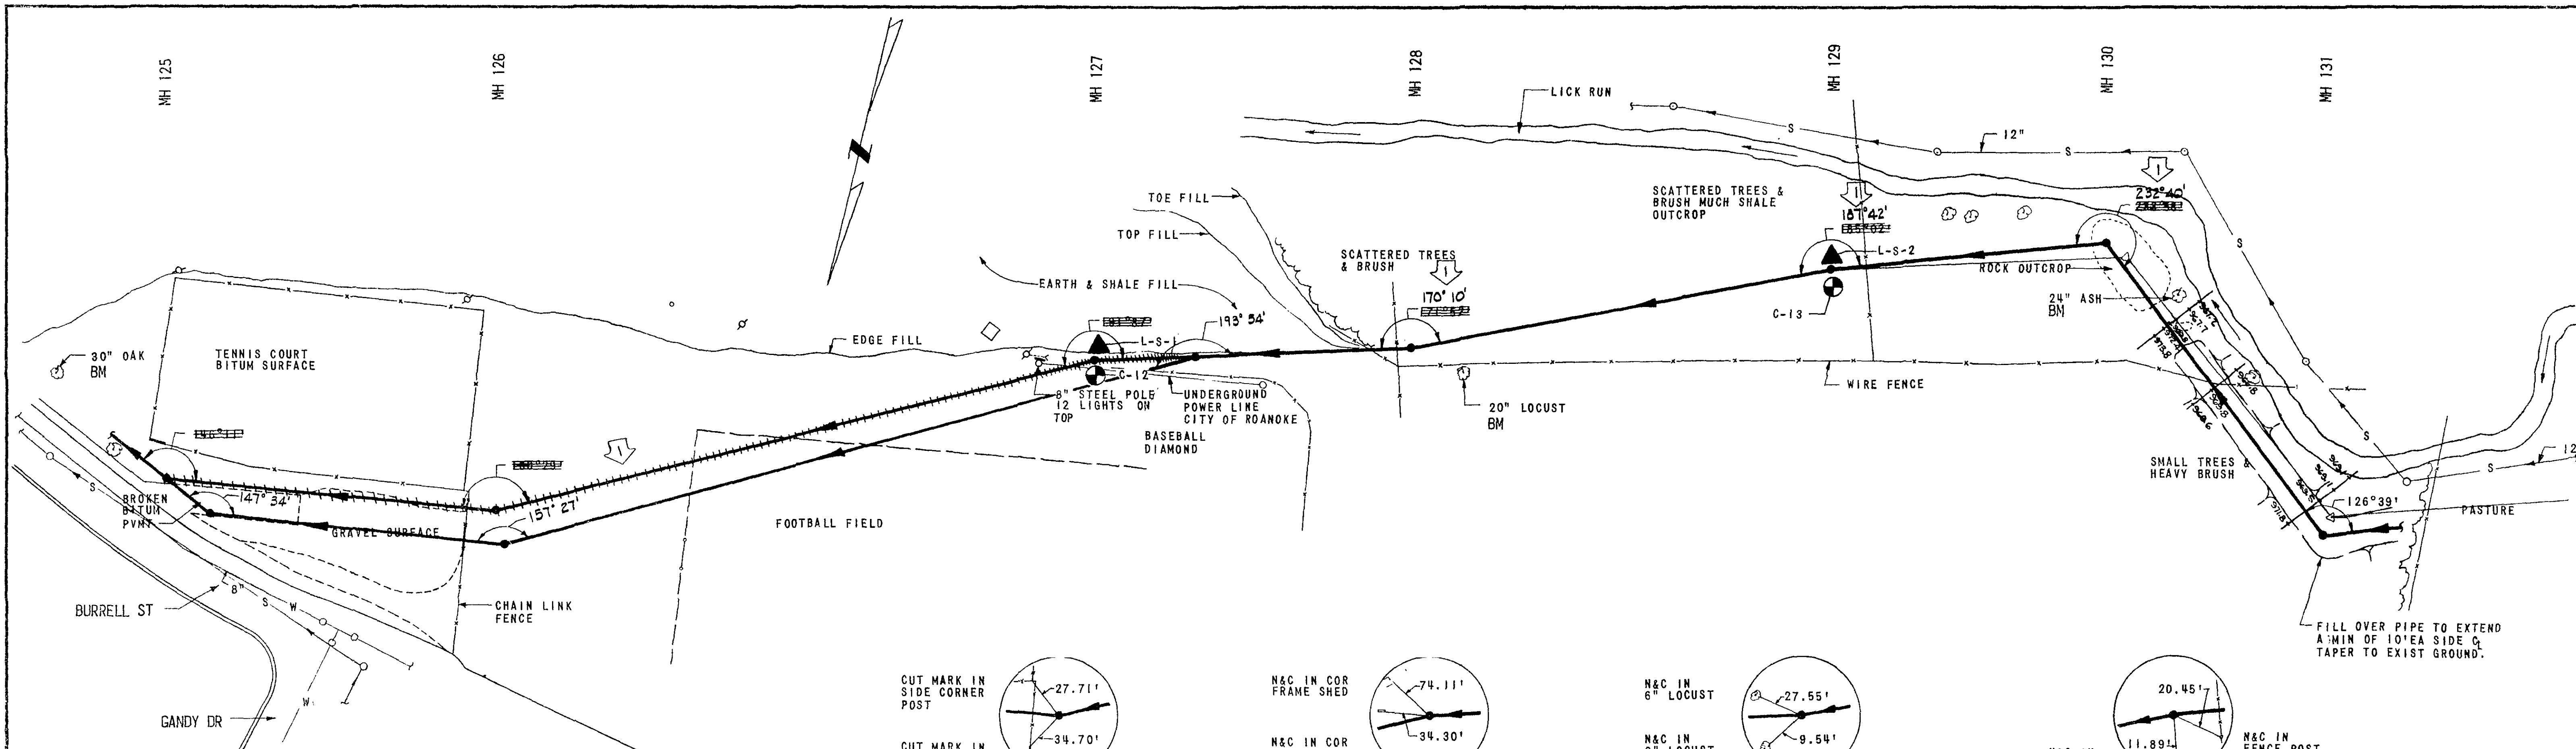

BM N&C IN BASE 30" OAK 6' LT. STA 2+55 BETWEEN MH 124 & MH 125 @ TENNIS COURT ON WEST SIDE OF BURRELL ST ELEV 990.47

BM N&C IN ROOT 20" LOCUST 15'± RT STA 0+30 BETWEEN MH 128 & MH 129 ELEV 993.55


MH 126

MH 127


MH 128

MH 129


BM N&C IN BASE 24" ASH 10'± LT STA 0+32 BETWEEN MH 130 & MH 131 ON BANK LICK RUN ELEV 969.22

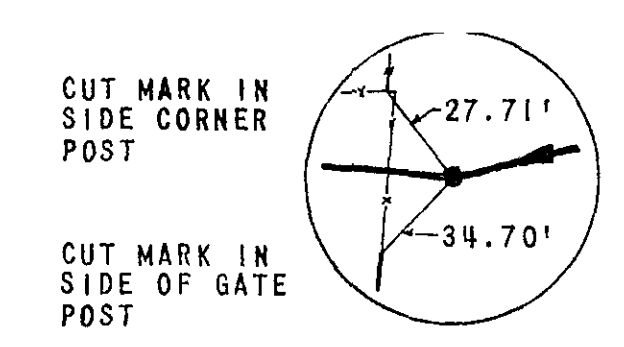


N&C IN COR FRAME SHED
N&C IN COR SW BOX

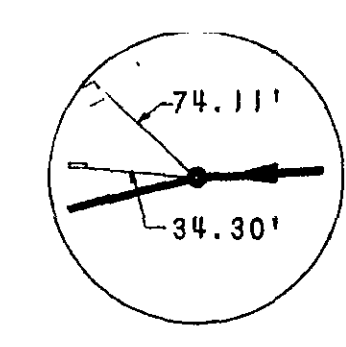

N&C IN 6" LOCUST
N&C IN 8" LOCUST

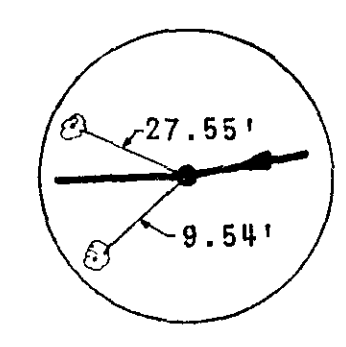


N&C IN 8" LOCUST

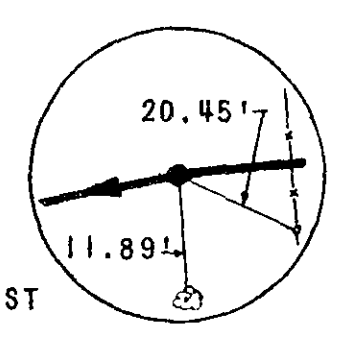

N&C IN FENCE POST

PROFILE	SURVEYED	DATE
	PLOTTED	BY
NO.	NOTE BOOK	GRADES CHECKED
	NO.	STRUCTURE NOTATION CHNG

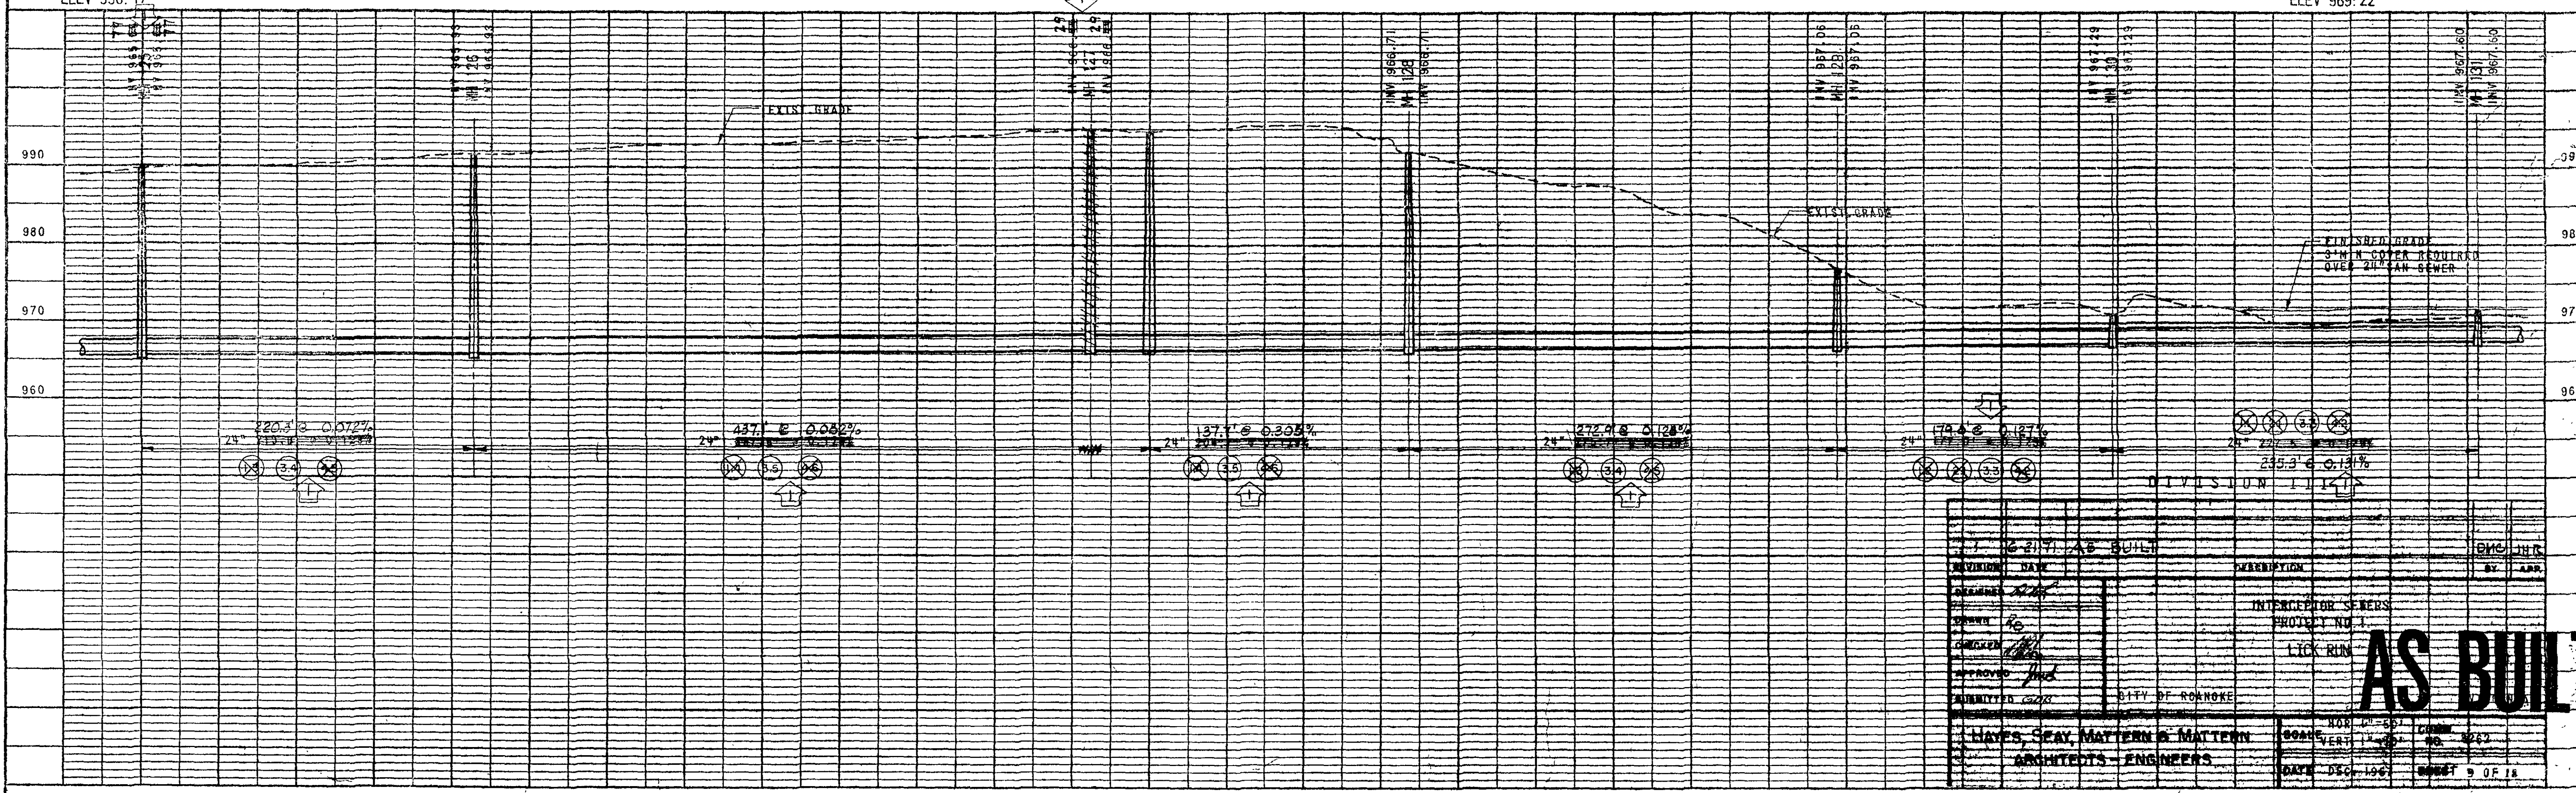

12" 24" 202	
--	--