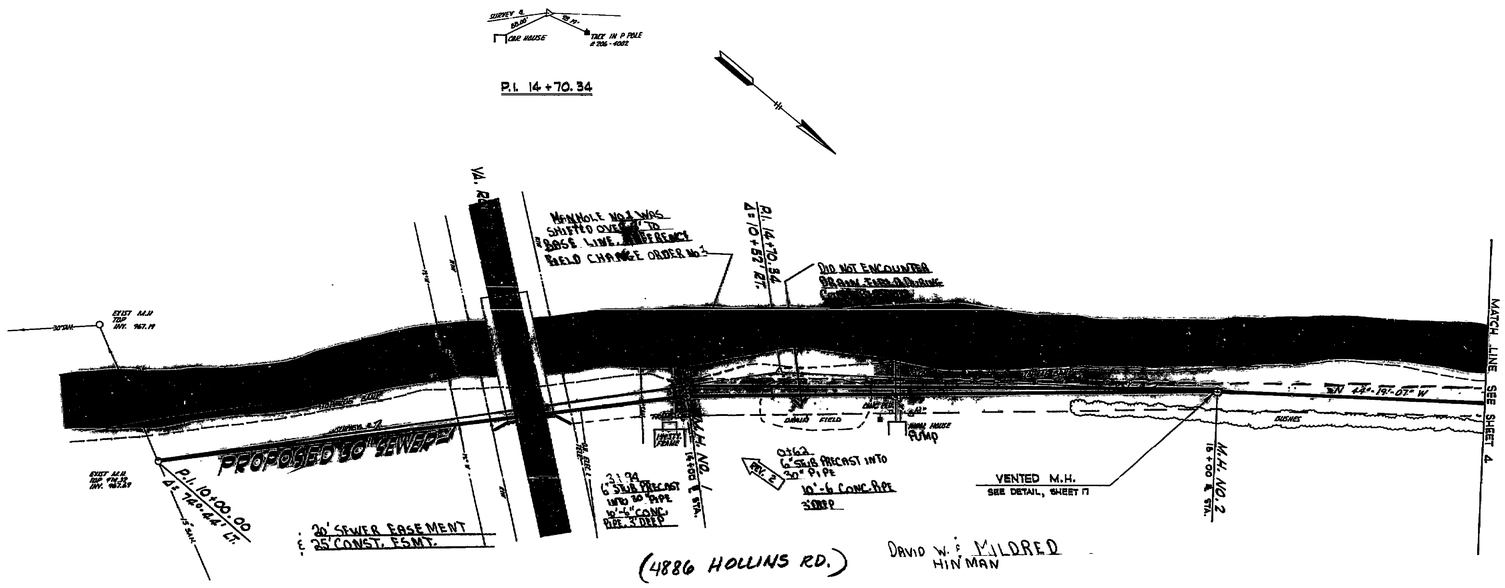

PLAN

NOTE:
M.H. NOS. 1 & 2 SHALL BE RICHARD FOUNDRY CO. NO. S-1444 WATERTIGHT DESIGN OR EQUAL.

1. IF SEWER LINE INSTALLATION DAMAGES SEPTIC TANK, COUNTY WILL PROVIDE FREE HOOK UP. – NO DAMAGE.
2. IF WELL INTAKE LINES ARE DAMAGED COUNTY WILL REPAIR AT NO COST – NO DAMAGE.
3. CONSTRUCTION EASEMENT: 25'

SCALE: 1 IN. = 50 FT.

PROFILE

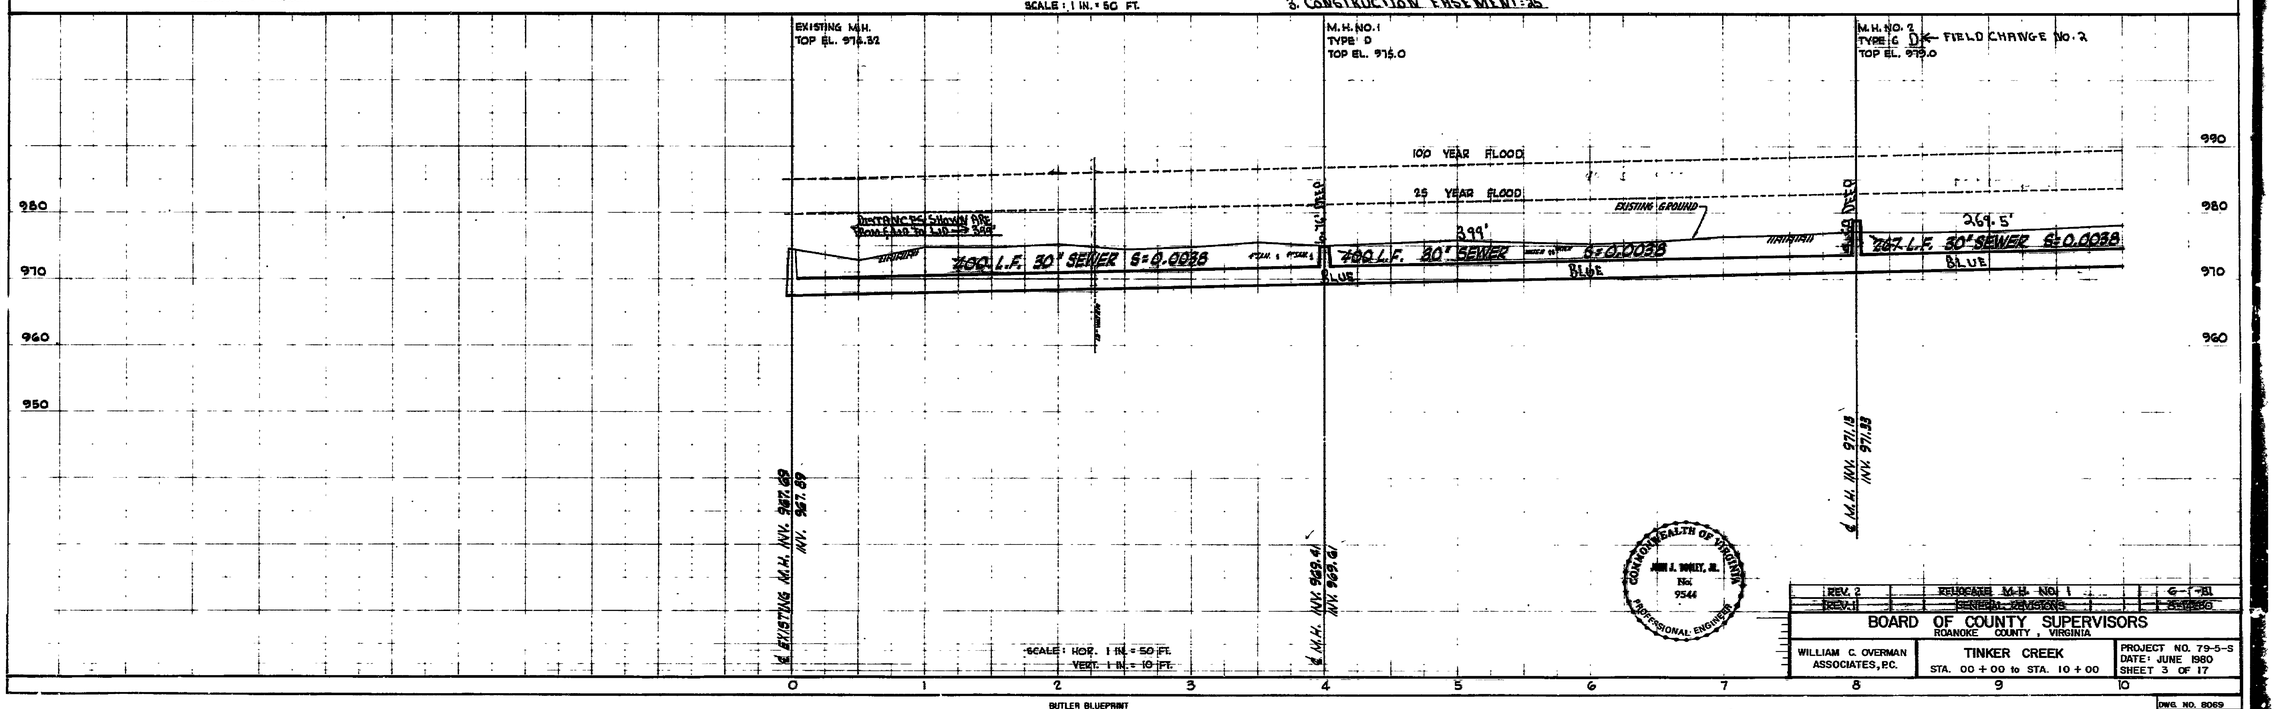

COMMONWEALTH OF VIRGINIA
JOHN J. DOOLEY, JR.
No. 9544
PROFESSIONAL ENGINEER

REV. 2	RELOCATE M.H. NO. 1		6-1-81
REV. 1	GENERAL REVISIONS		5-13-80

BOARD OF COUNTY SUPERVISORS
ROANOKE COUNTY, VIRGINIA

WILLIAM C. OVERMAN ASSOCIATES, P.C.	TINKER CREEK STA. 00+00 to STA. 10+00	PROJECT NO. 79-5-S DATE: JUNE 1980 SHEET 3 OF 17

DWG. NO. 8069

BUTLER BLUEPRINT
Norfolk Va. — Virginia Beach Va.

C-510535-03

ST 0079