PLAN

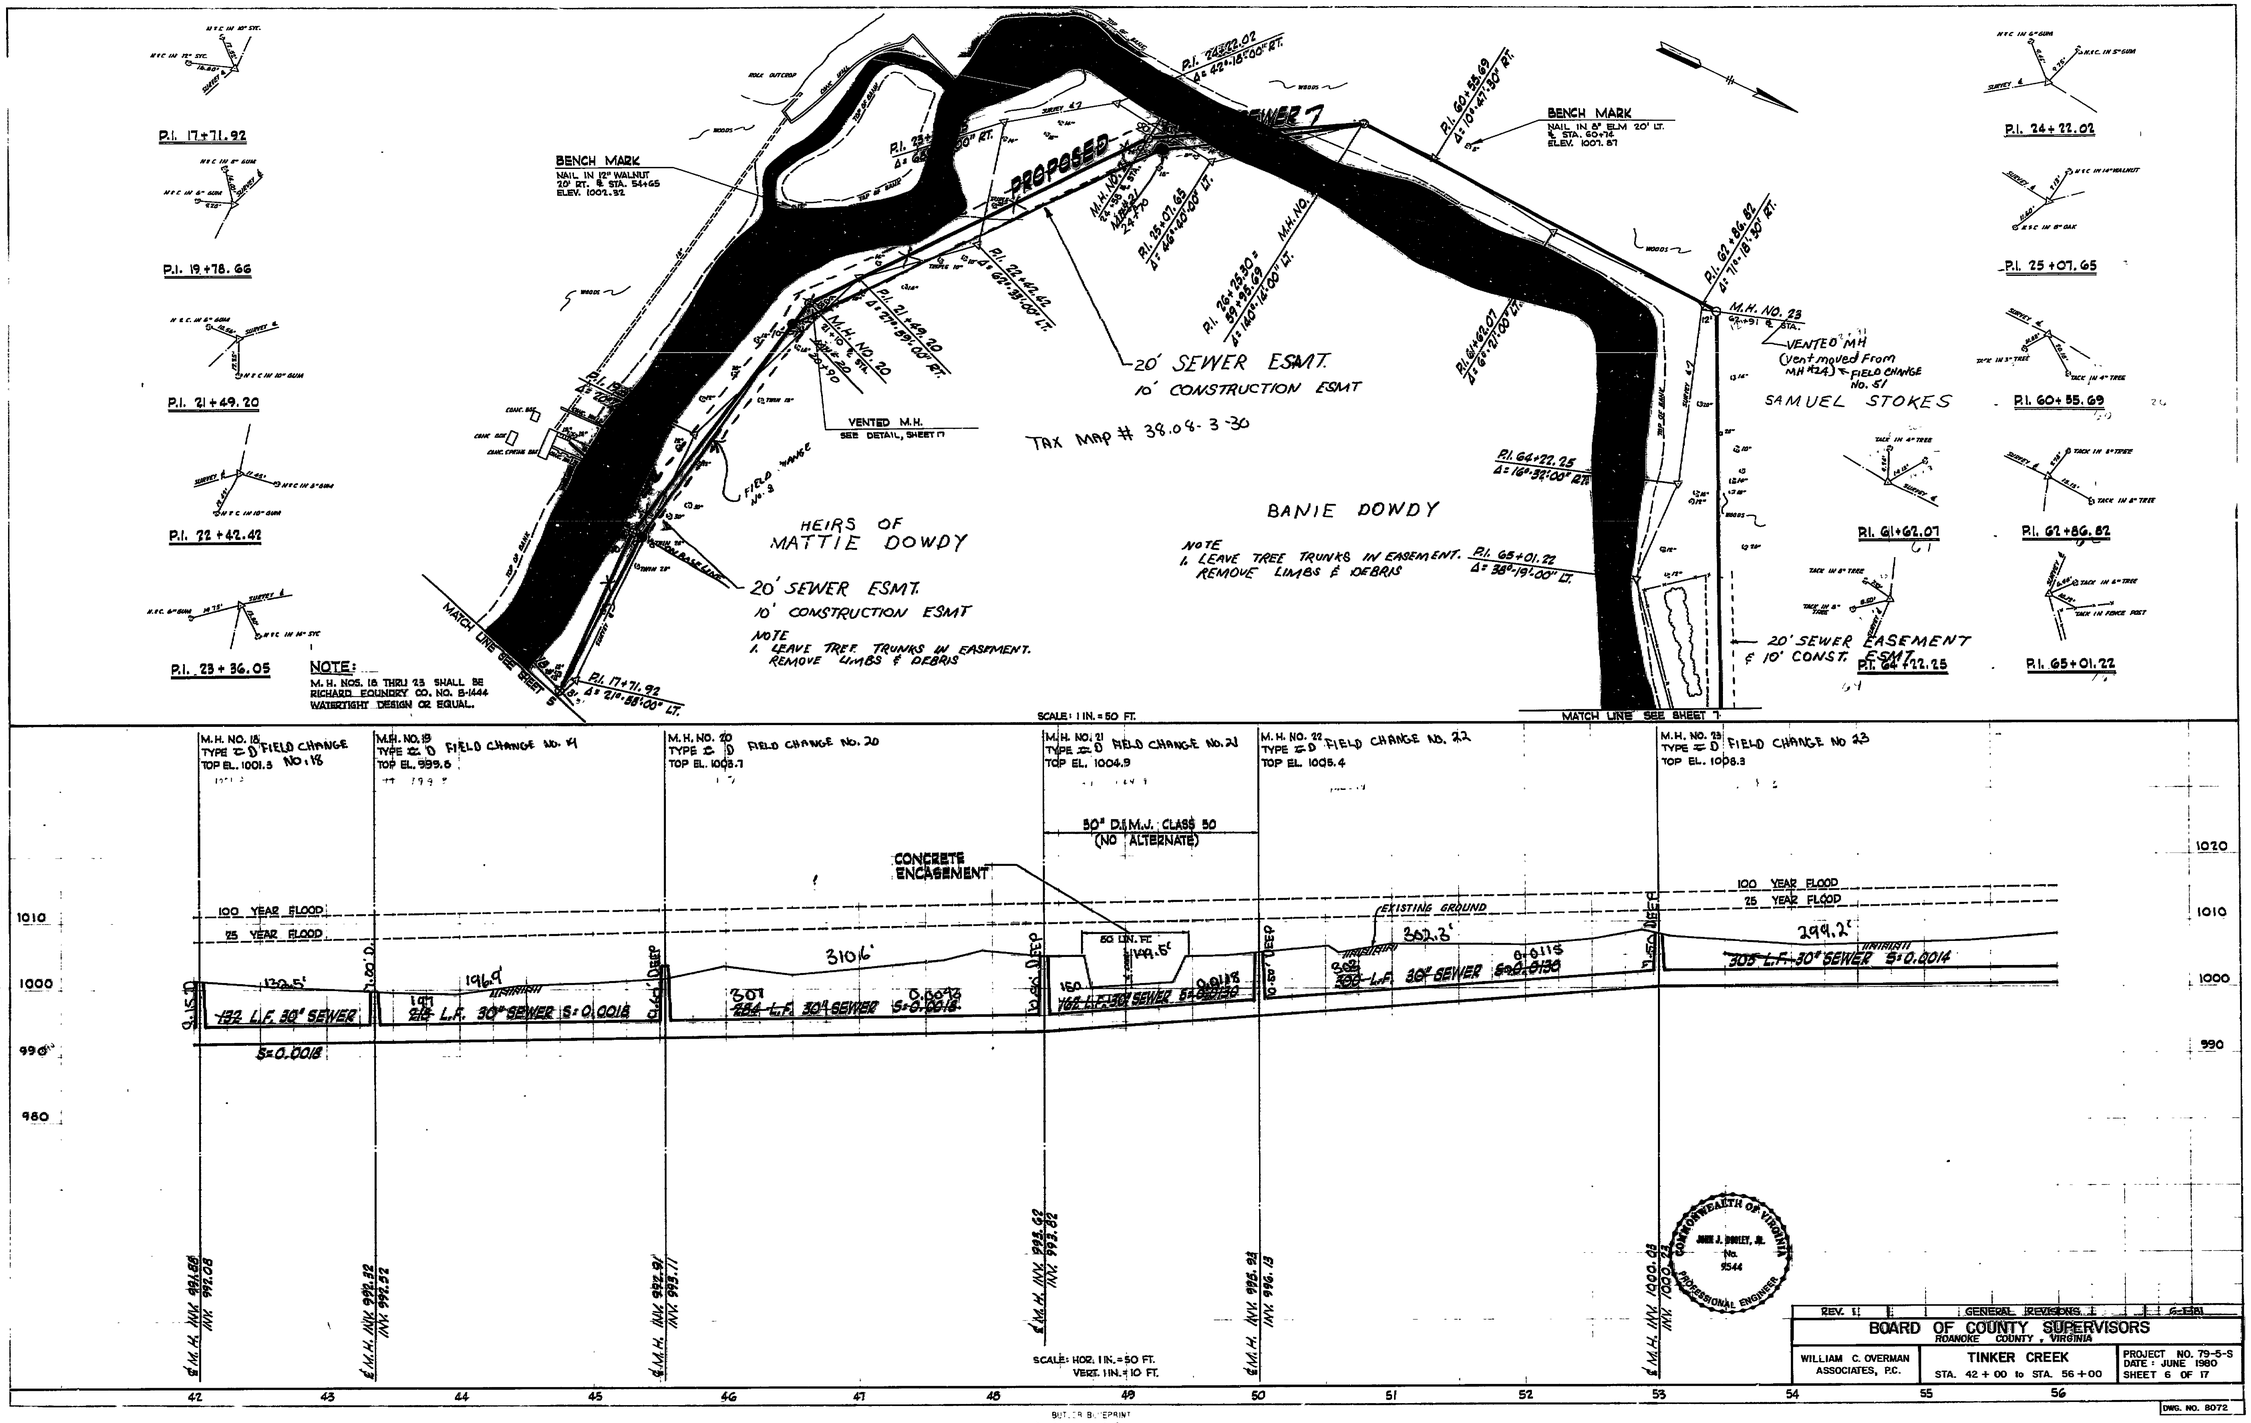

PROFILE

COMMONWEALTH OF VIRGINIA
JOHN J. DORLEY, JR.
No. 9544
PROFESSIONAL ENGINEER

REV.	GENERAL REVISIONS	DATE

BOARD OF COUNTY SUPERVISORS
ROANOKE COUNTY, VIRGINIA

WILLIAM C. OVERMAN ASSOCIATES, P.C.	TINKER CREEK STA. 42 + 00 to STA. 56 + 00	PROJECT NO. 79-5-S DATE: JUNE 1980 SHEET 6 OF 17

DWG. NO. 8072

C-510535-03 SI-0082