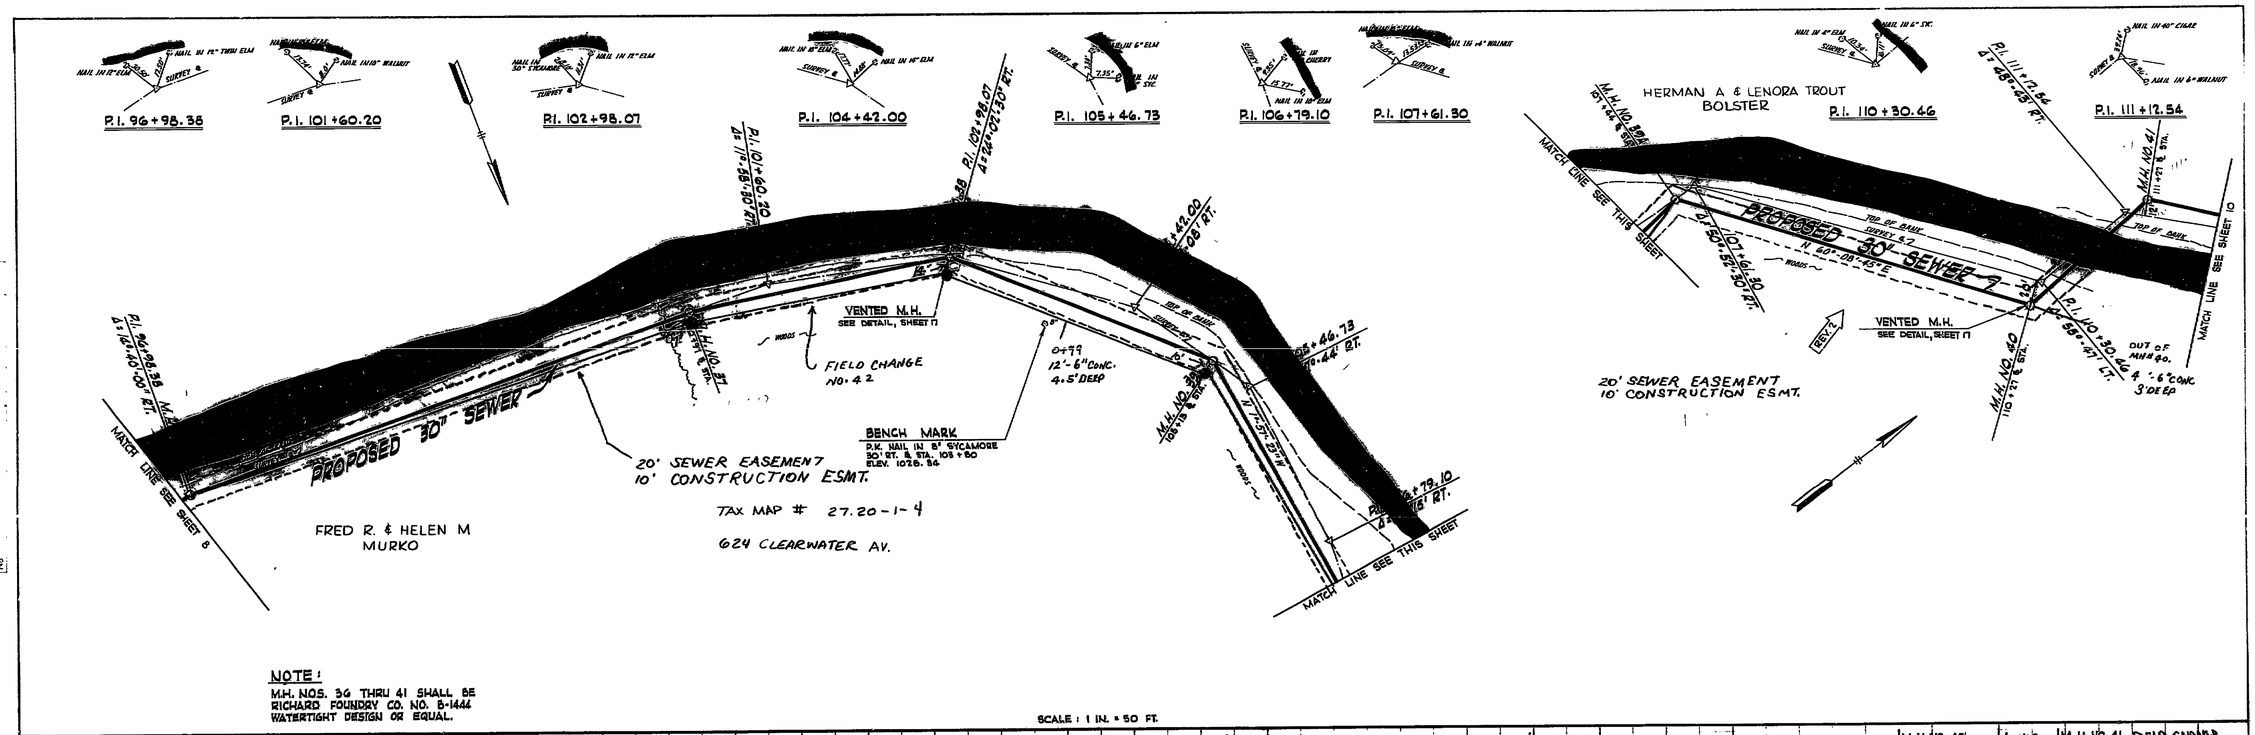
P.I. 96+98.38
P.I. 101+60.20
P.I. 102+98.07
P.I. 104+42.00
P.I. 105+46.73
P.I. 106+79.10
P.I. 107+61.30
P.I. 110+30.66
P.I. 111+12.54
HERMAN A & LENORA TROUT BOLSTER
FRED R. & HELEN M MURKO
PROPOSED 30" SEWER
20' SEWER EASEMENT
10' CONSTRUCTION ESMT.
TAX MAP # 27.20-1-4
624 CLEARWATER AV.
VENTED M.H.
SEE DETAIL, SHEET 17
FIELD CHANGE NO. 42
BENCH MARK
P.K. NAIL IN 8" SYCAMORE 30' RT. & STA. 105+50 ELEV. 1028.36
0+99 12'-6" CONC. 4.5' DEEP
OUT OF M.H. #40. 4'-6" CONC. 3' DEEP
MATCH LINE SEE SHEET 8
MATCH LINE SEE THIS SHEET
MATCH LINE SEE SHEET 10
NOTE:
M.H. NOS. 36 THRU 41 SHALL BE RICHARD FOUNDRY CO. NO. B-1444 WATERTIGHT DESIGN OR EQUAL.
SCALE: 1 IN. = 50 FT.
M.H. NO. 36 TYPE #D FIELD CHANGE No. 39 TOP EL. 1024.2
M.H. NO. 37 TYPE #D FIELD CHANGE No. 43 TOP EL. 1024.2
M.H. NO. 38 TYPE #D FIELD CHANGE No. 44 TOP EL. 1026.8
M.H. NO. 39 TYPE #D FIELD CHANGE No. 46 TOP EL. 1026.5
M.H. NO. 39A TYPE #D FIELD CHANGE No. 47 TOP EL. 1027.6
M.H. NO. 40 TYPE #D FIELD CHANGE No. 49 TOP EL. 1030.0
M.H. NO. 41 TYPE #D FIELD CHANGE No. 50 TOP EL. 1031.0
30" D.I.M.J. CLASS 50 (NO ALTERNATE)
CONCRETE ENCASEMENT
100 YEAR FLOOD
25 YEAR FLOOD
400 L.F. 30" SEWER S=0.0014
200 L.F. 30" SEWER S=0.0014
202 L.F. 30" SEWER S=0.0014
208 L.F. 30" SEWER S=0.0014
276 L.F. 30" SEWER S=0.0014
120 L.F. 30" SEWER S=0.0014
15 LIN. FT.
SCALE: HOR. 1 IN. = 50 FT. VERT. 1 IN. = 10 FT.
COMMONWEALTH OF VIRGINIA
JOHN J. DONLEY, JR.
No. 9544
PROFESSIONAL ENG. HEER
REV. 3 GENERAL REVISIONS 6-1-81
REV. 2 GENERAL REVISIONS 3-10-81
REV. 1 GENERAL REVISIONS 7-25-80
BOARD OF COUNTY SUPERVISORS
ROANOKE COUNTY, VIRGINIA
WILLIAM C. OVERMAN ASSOCIATES, PC
TINKER CREEK
STA. 86+00 to STA. 101+00
PROJECT NO. 79-5-S
DATE: JUNE 1980
SHEET 9 OF 17
DWG. NO. 8075
BUTLER BLUEPRINT
Need to Check
C-510535-03
SI-0085