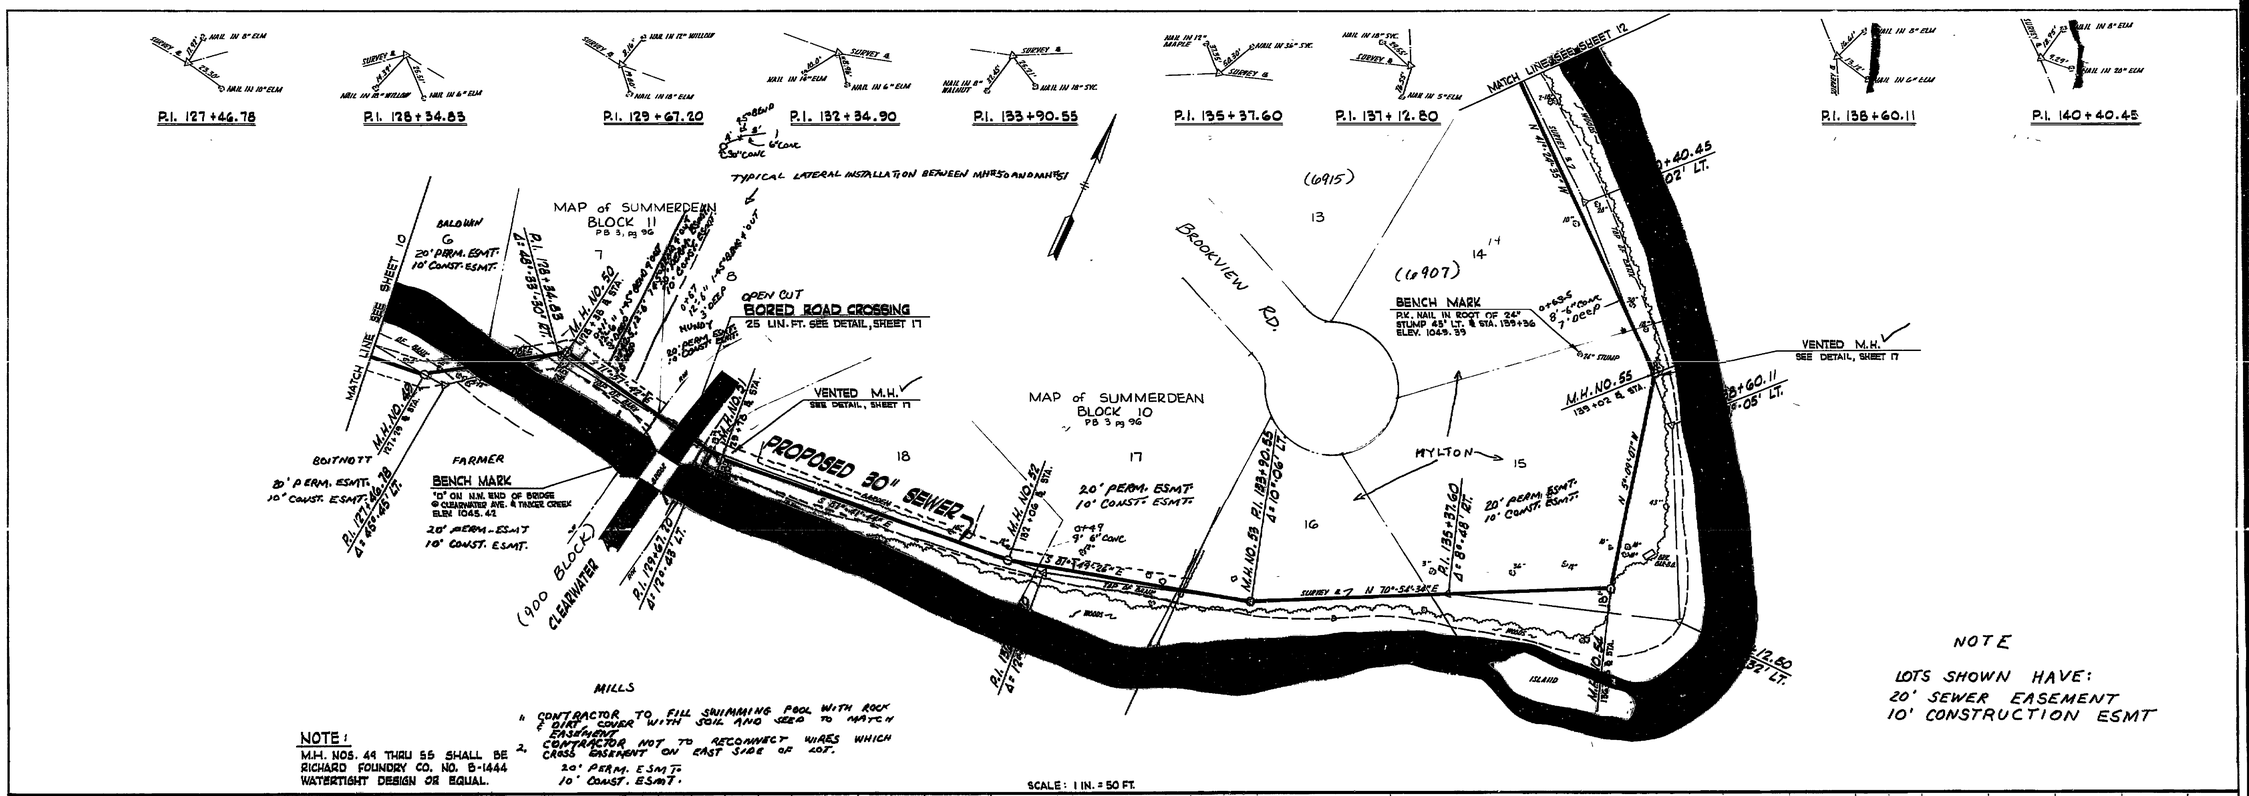

Need to check
C-510535-03

SI-0087