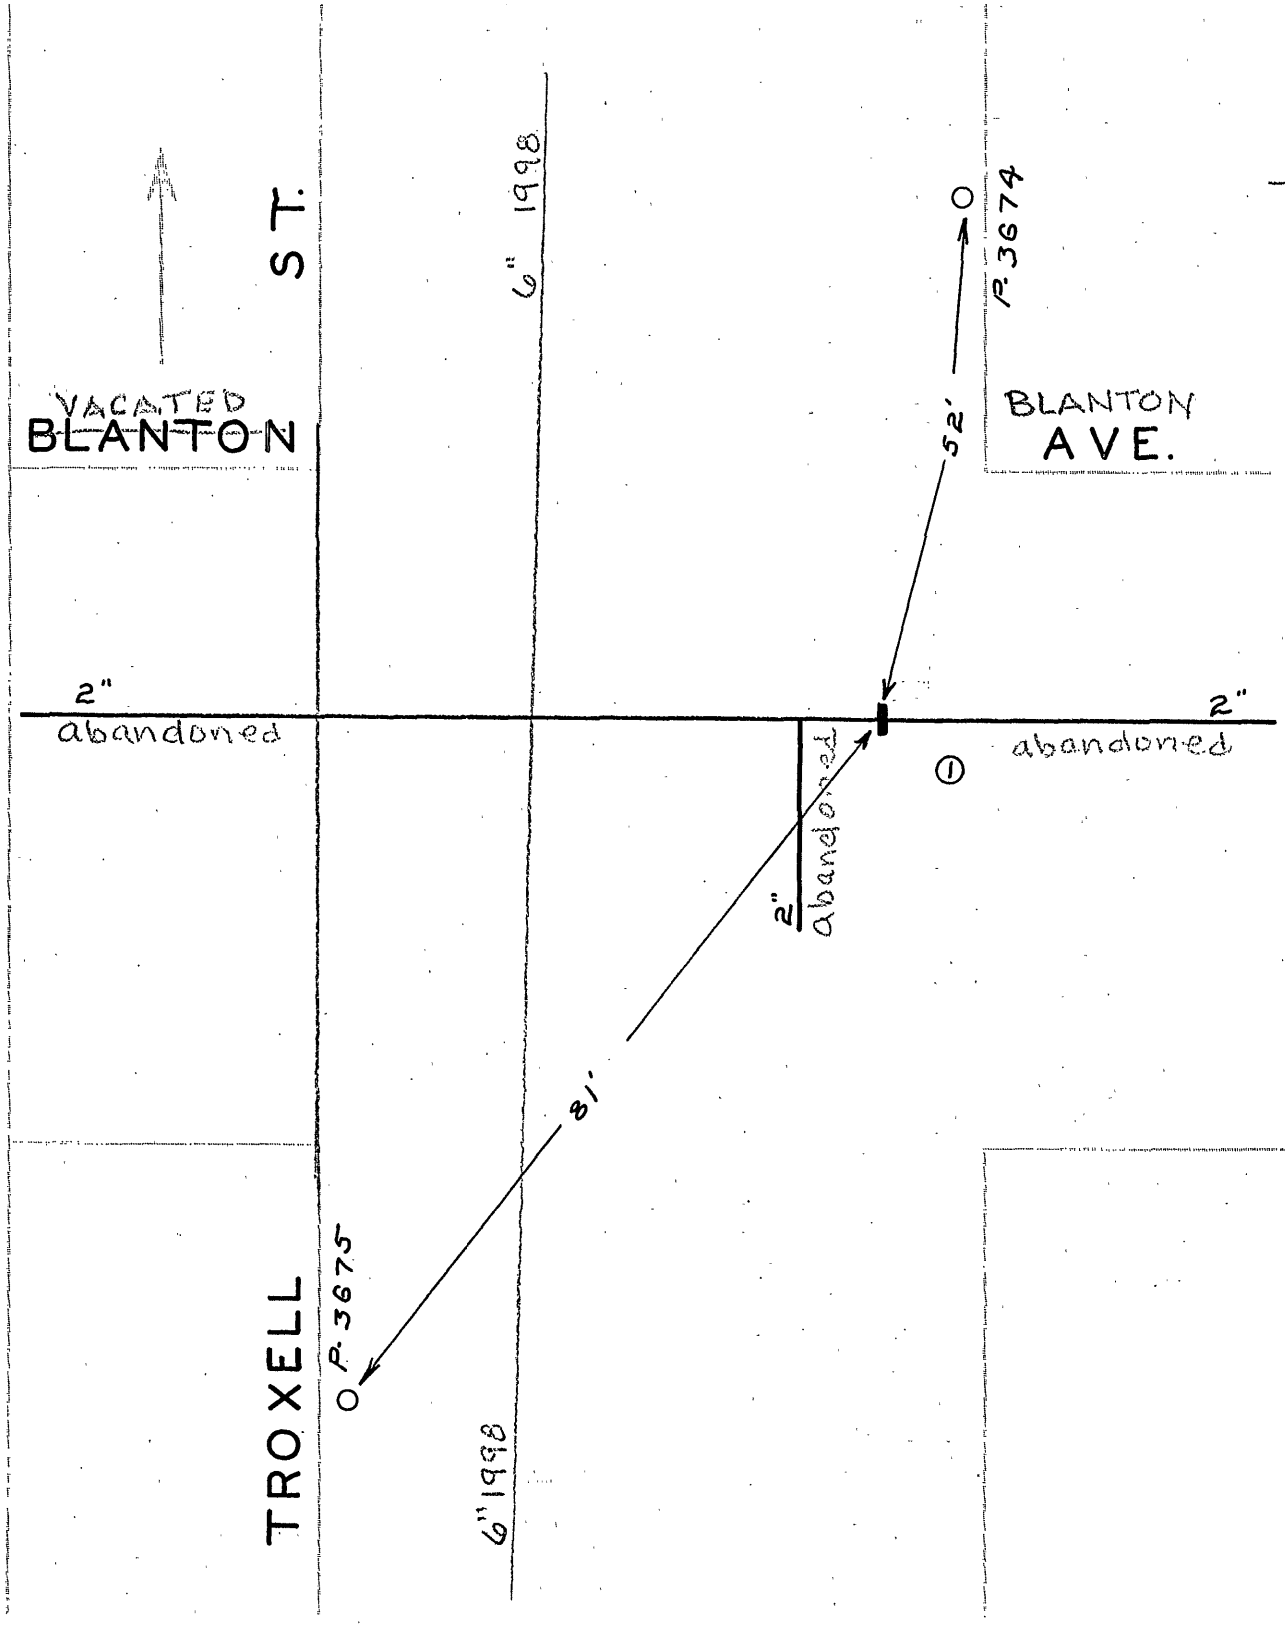

DATE	NO.	SIZE	MAKE	OPEN	TURNS
~~G.C.~~	~~1~~	~~2"~~			

CITY OF ROANOKE — WATER DEPT.

VALVE DIAGRAM

BLANTON AVE. &
TROXELL ST. S. E.

SEC. MAP 439

DATE PAGE NO.