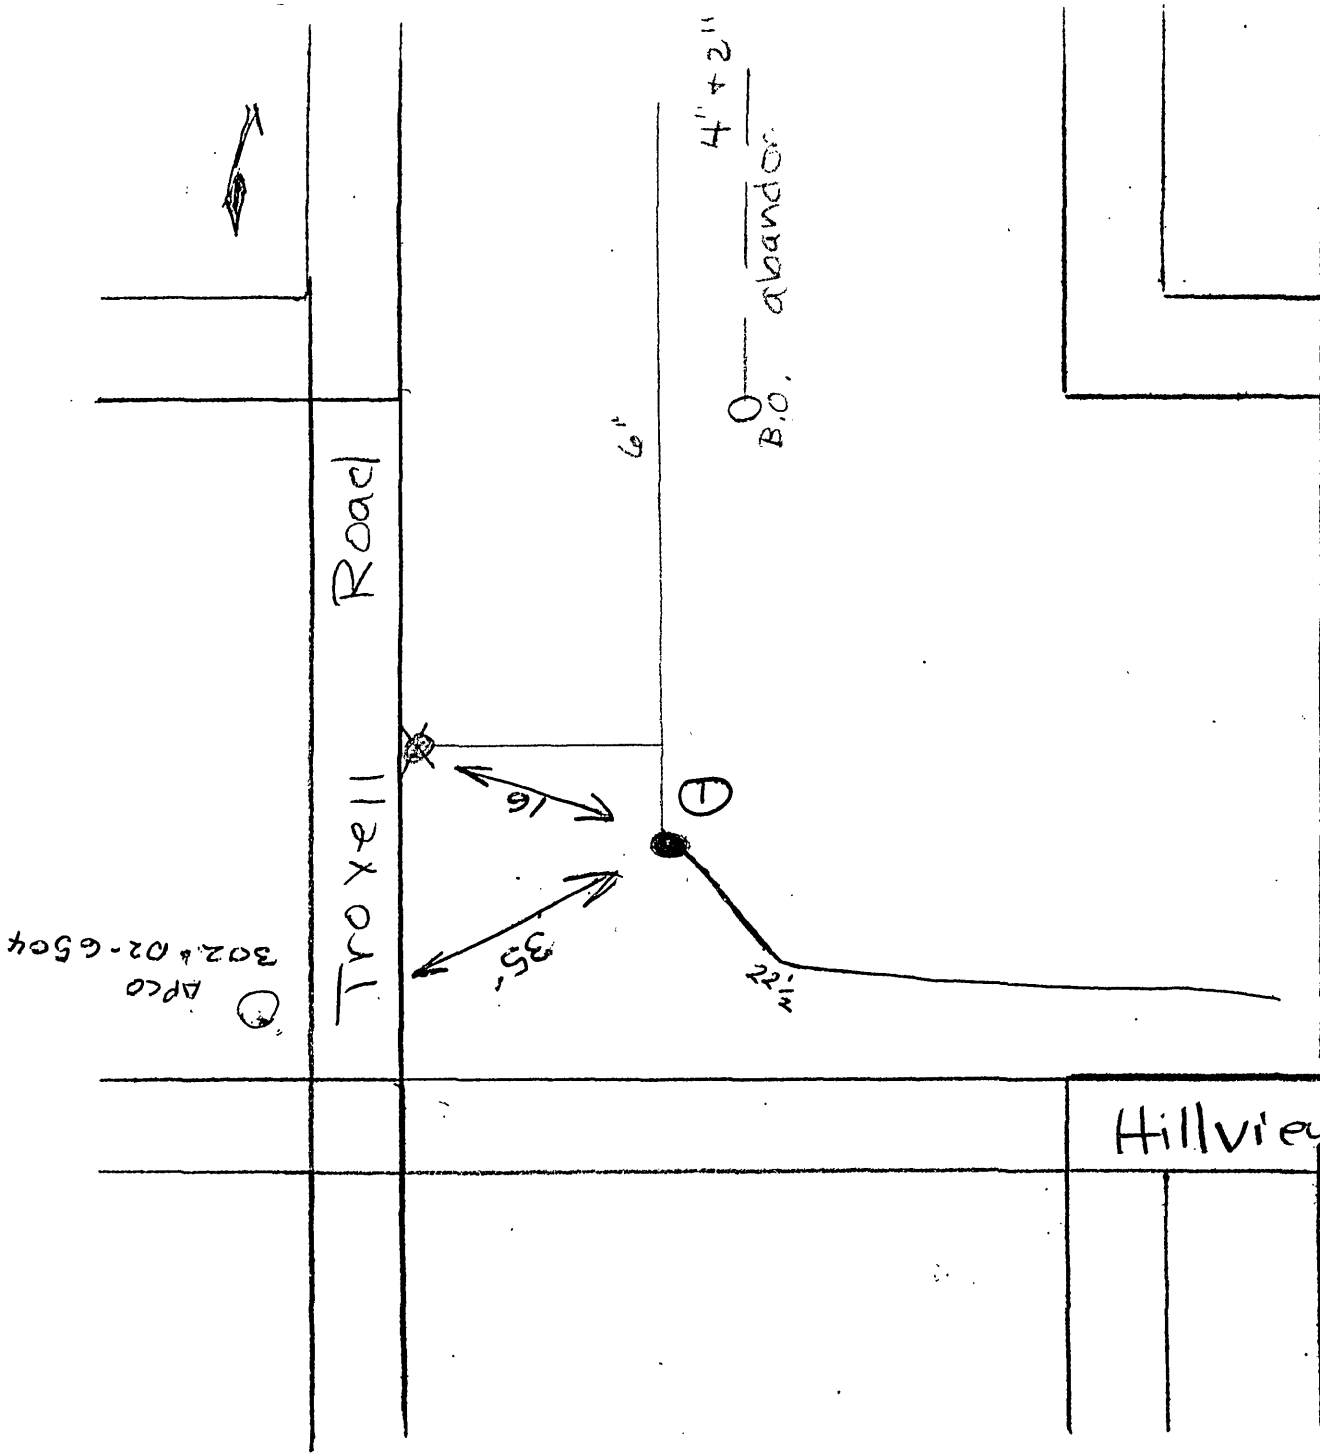

DATE	NO.	SIZE	MAKE	OPEN	TURNS
2-98	1	6"	MU.	R	21

P. L. Measurements		
No.	Distance	Direction

CITY OF ROANOKE - WATER DEPT.

VALVE DIAGRAM

Hillview Ave.
Troxell Rd.

Sec. Map 439 SE

Date Page No.