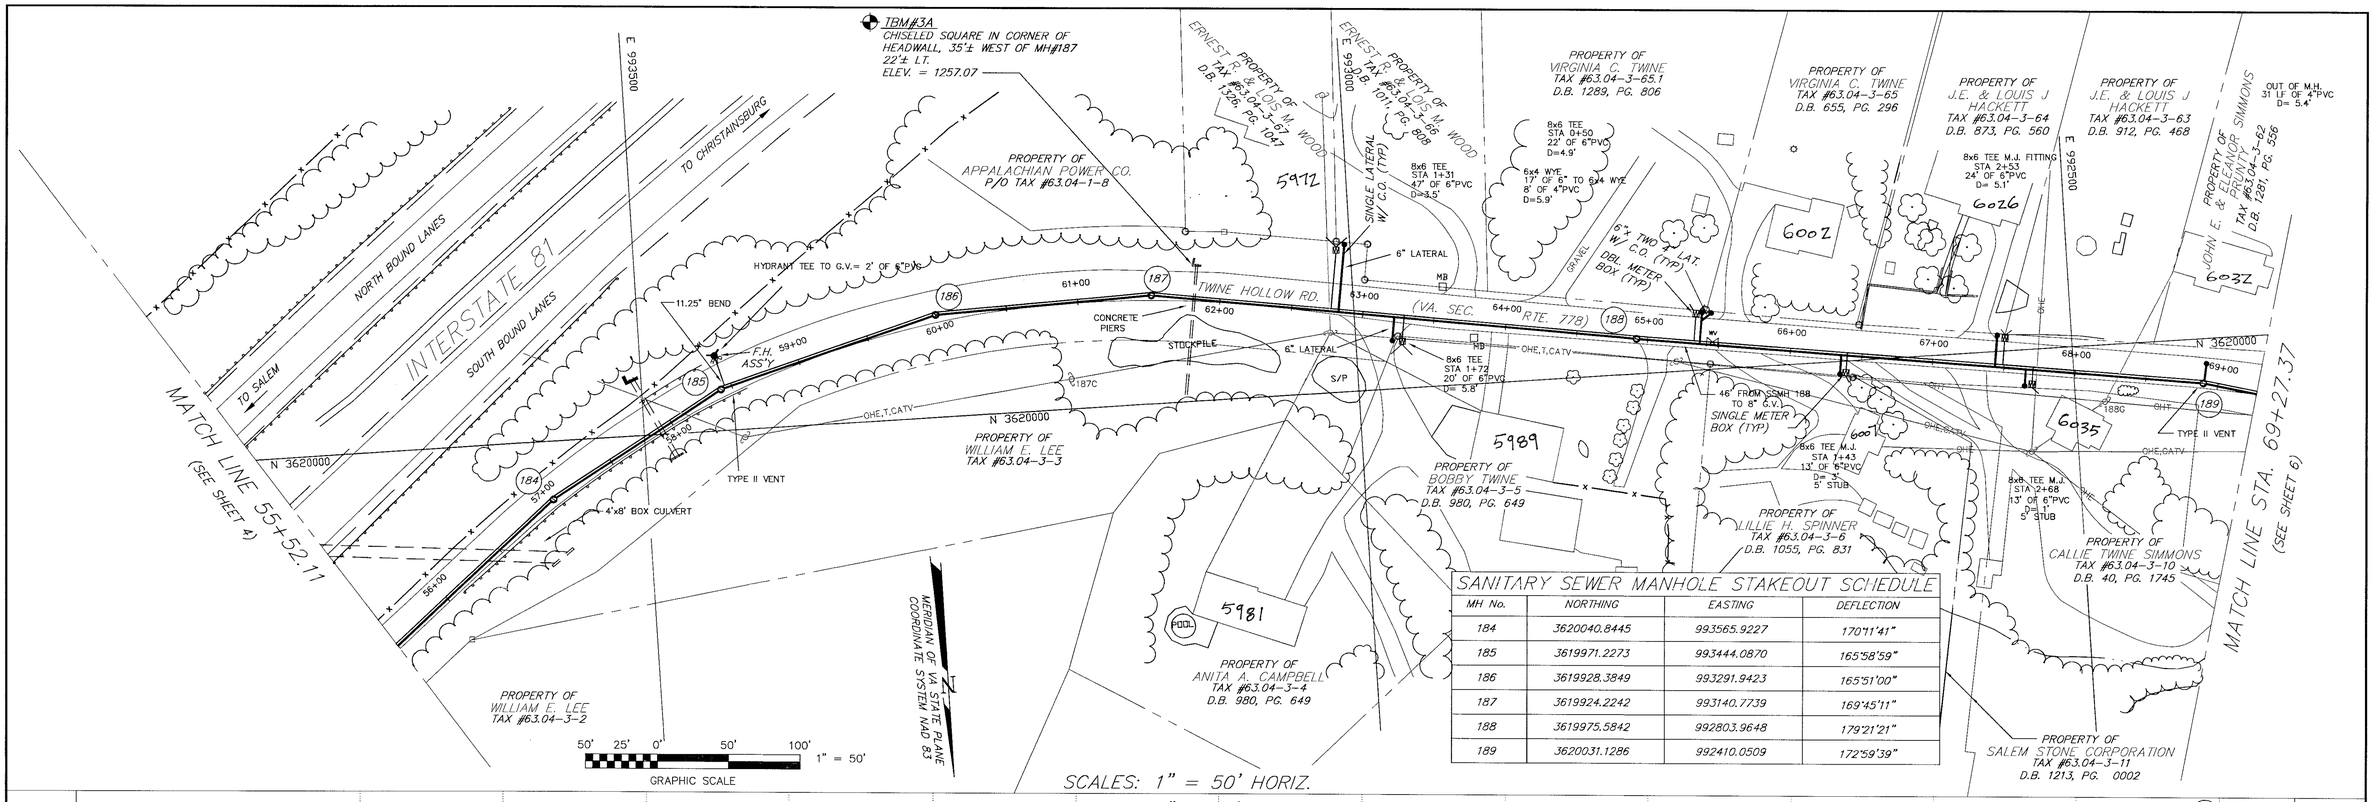

SANITARY SEWER MANHOLE STAKEOUT SCHEDULE

MH No.	NORTHING	EASTING	DEFLECTION
184	3620040.8445	993565.9227	170°11'41"
185	3619971.2273	993444.0870	165°58'59"
186	3619928.3849	993291.9423	165°51'00"
187	3619924.2242	993140.7739	169°45'11"
188	3619975.5842	992803.9648	179°21'21"
189	3620031.1286	992410.0509	172°59'39"

SCALES: 1" = 50' HORIZ.
1" = 10' VERT.

8" SANITARY SEWER & 8" WATERLINE

"AS BUILT"

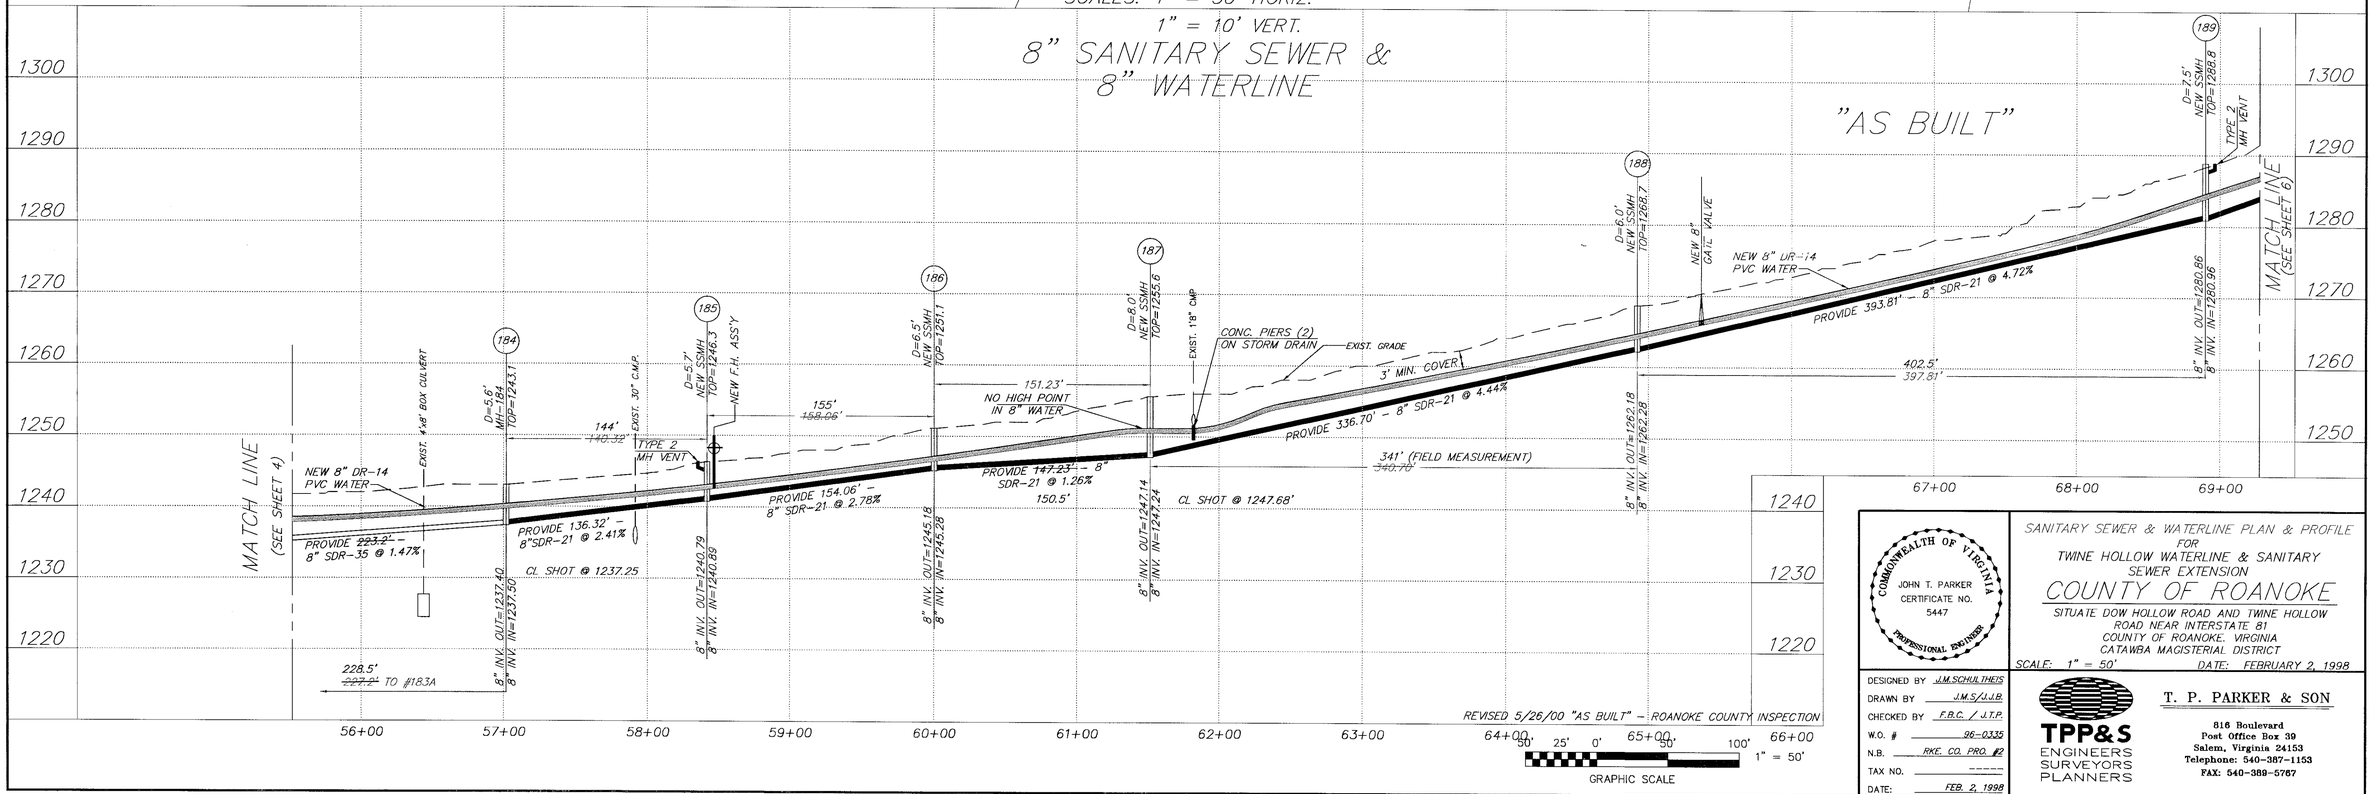

COMMONWEALTH OF VIRGINIA
JOHN T. PARKER
CERTIFICATE NO. 5447
PROFESSIONAL ENGINEER

SANITARY SEWER & WATERLINE PLAN & PROFILE
FOR
TWINE HOLLOW WATERLINE & SANITARY SEWER EXTENSION

COUNTY OF ROANOKE

SITUATE DOW HOLLOW ROAD AND TWINE HOLLOW ROAD NEAR INTERSTATE 81
COUNTY OF ROANOKE, VIRGINIA
CATAWBA MAGISTERIAL DISTRICT

SCALE: 1" = 50' DATE: FEBRUARY 2, 1998

DESIGNED BY J.M.SCHULTHEIS
DRAWN BY J.M.S./J.J.B.
CHECKED BY F.B.C. / J.T.P.
W.O. # 96-0335
N.B. RKE. CO. PRO. #2
TAX NO. ------
DATE: FEB. 2, 1998

TPP&S
ENGINEERS SURVEYORS PLANNERS

T. P. PARKER & SON
816 Boulevard
Post Office Box 39
Salem, Virginia 24153
Telephone: 540-387-1153
FAX: 540-389-5767