



UTILITY PLAN, SANITARY SEWER

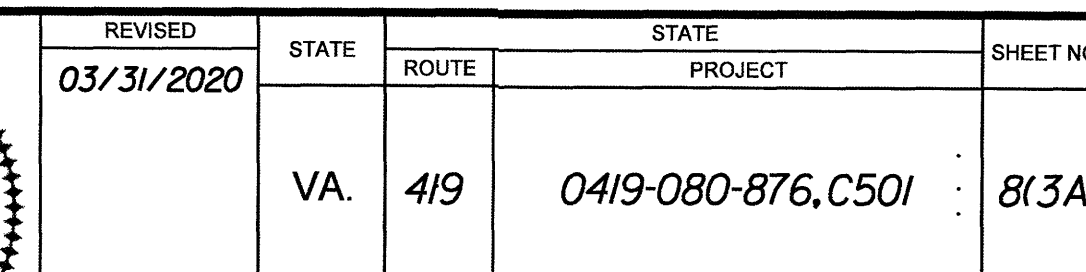

Paula J. Moore
Digitally signed by Paula J. Moore
DN: cn=Paula J. Moore, o=PEI, email=
Paula.Moore@peiconsulting.com,
serial=142705059155616AC640980,
email=paula.moore@peiconsulting.com

Blacksburg, Virginia
UTILITIES ENGINEER

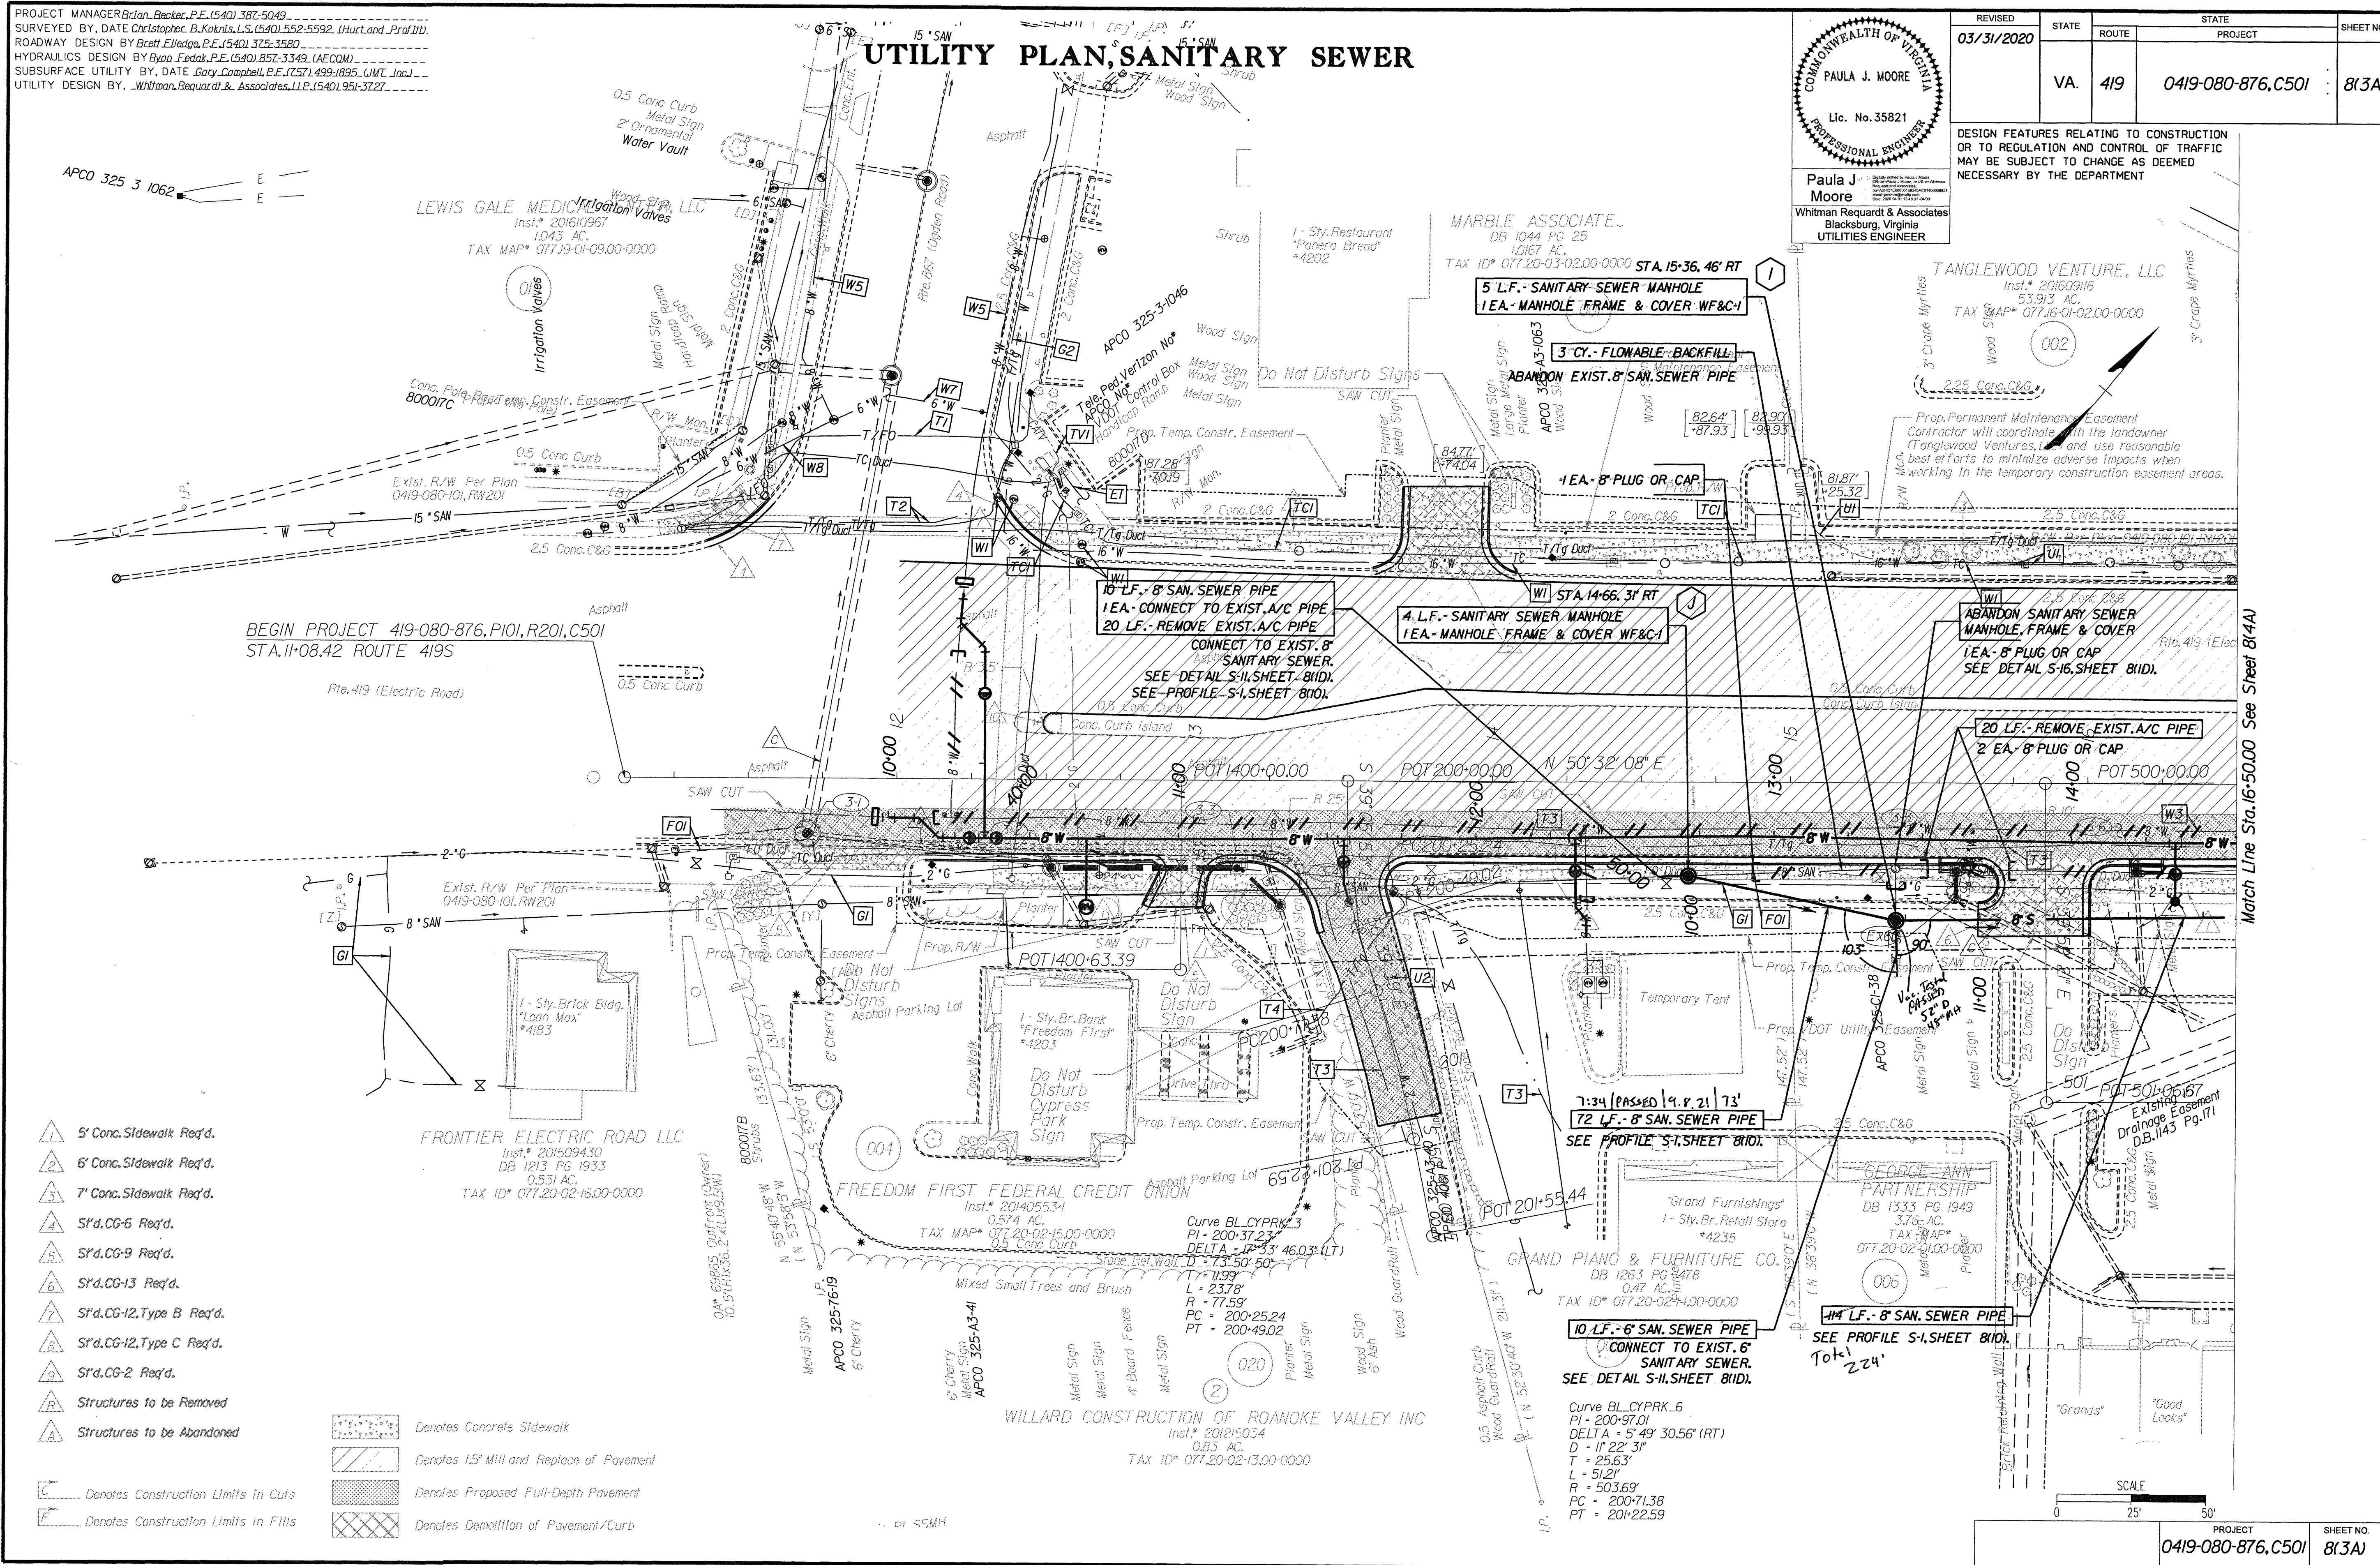

Match Line Sta. 16+50.00 See Sheet 8(4A)

THIS SHEET FOR UTILITY ADJUSTMENT/RELOCATION ONLY