


PROJECT MANAGER: Brian Becker, P.E. (540) 387-5049
SURVEYED BY: DATE: Christopher B. Kohns, L.S. (540) 552-5592 (Hurtland, Prof. Eng.)
ROADWAY DESIGN BY: Brian Elledge, P.E. (540) 375-3500
HYDRAULICS DESIGN BY: Ryan Fedak, P.E. (540) 857-3349 (AECOM)
SUBSURFACE UTILITY BY: DATE: Gary Campbell, P.E. (757) 499-1896 (CMT, Inc.)
UTILITY DESIGN BY: Whitman Requardt & Associates, LLP (540) 951-3727

UTILITY PLAN, WATER

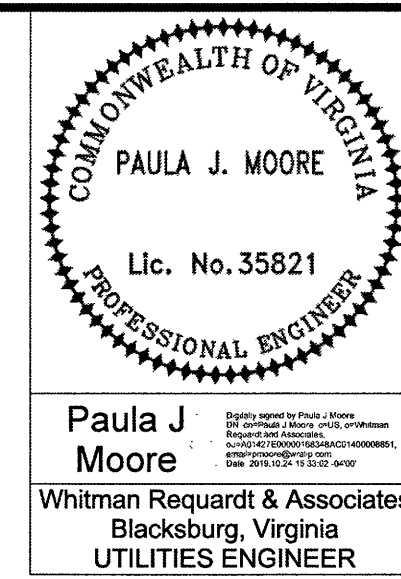



REVISED	STATE	ROUTE	STATE	PROJECT	SHEET NO.
	VA.	419		0419-080-876, C501	8(5)

DESIGN FEATURES RELATING TO CONSTRUCTION OR TO REGULATION AND CONTROL OF TRAFFIC MAY BE SUBJECT TO CHANGE AS DEEMED NECESSARY BY THE DEPARTMENT

- 5' Conc. Sidewalk Req'd.
 - 6' Conc. Sidewalk Req'd.
 - 7' Conc. Sidewalk Req'd.
 - S'd.CG-6 Req'd.
 - S'd.CG-9 Req'd.
 - S'd.CG-13 Req'd.
 - S'd.CG-12, Type B Req'd.
 - S'd.CG-12, Type C Req'd.
 - S'd.CG-2 Req'd.
 - Structures to be Removed
 - Structures to be Abandoned
- Denotes Concrete Sidewalk
- Denotes 1.5" Mill and Replace of Pavement
- Denotes Proposed Full-Depth Pavement
- Denotes Demolition of Pavement/Curb

Denotes Construction Limits in Cuts

Denotes Construction Limits in Fills

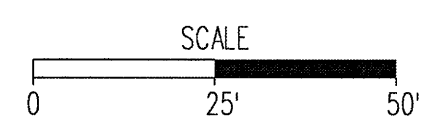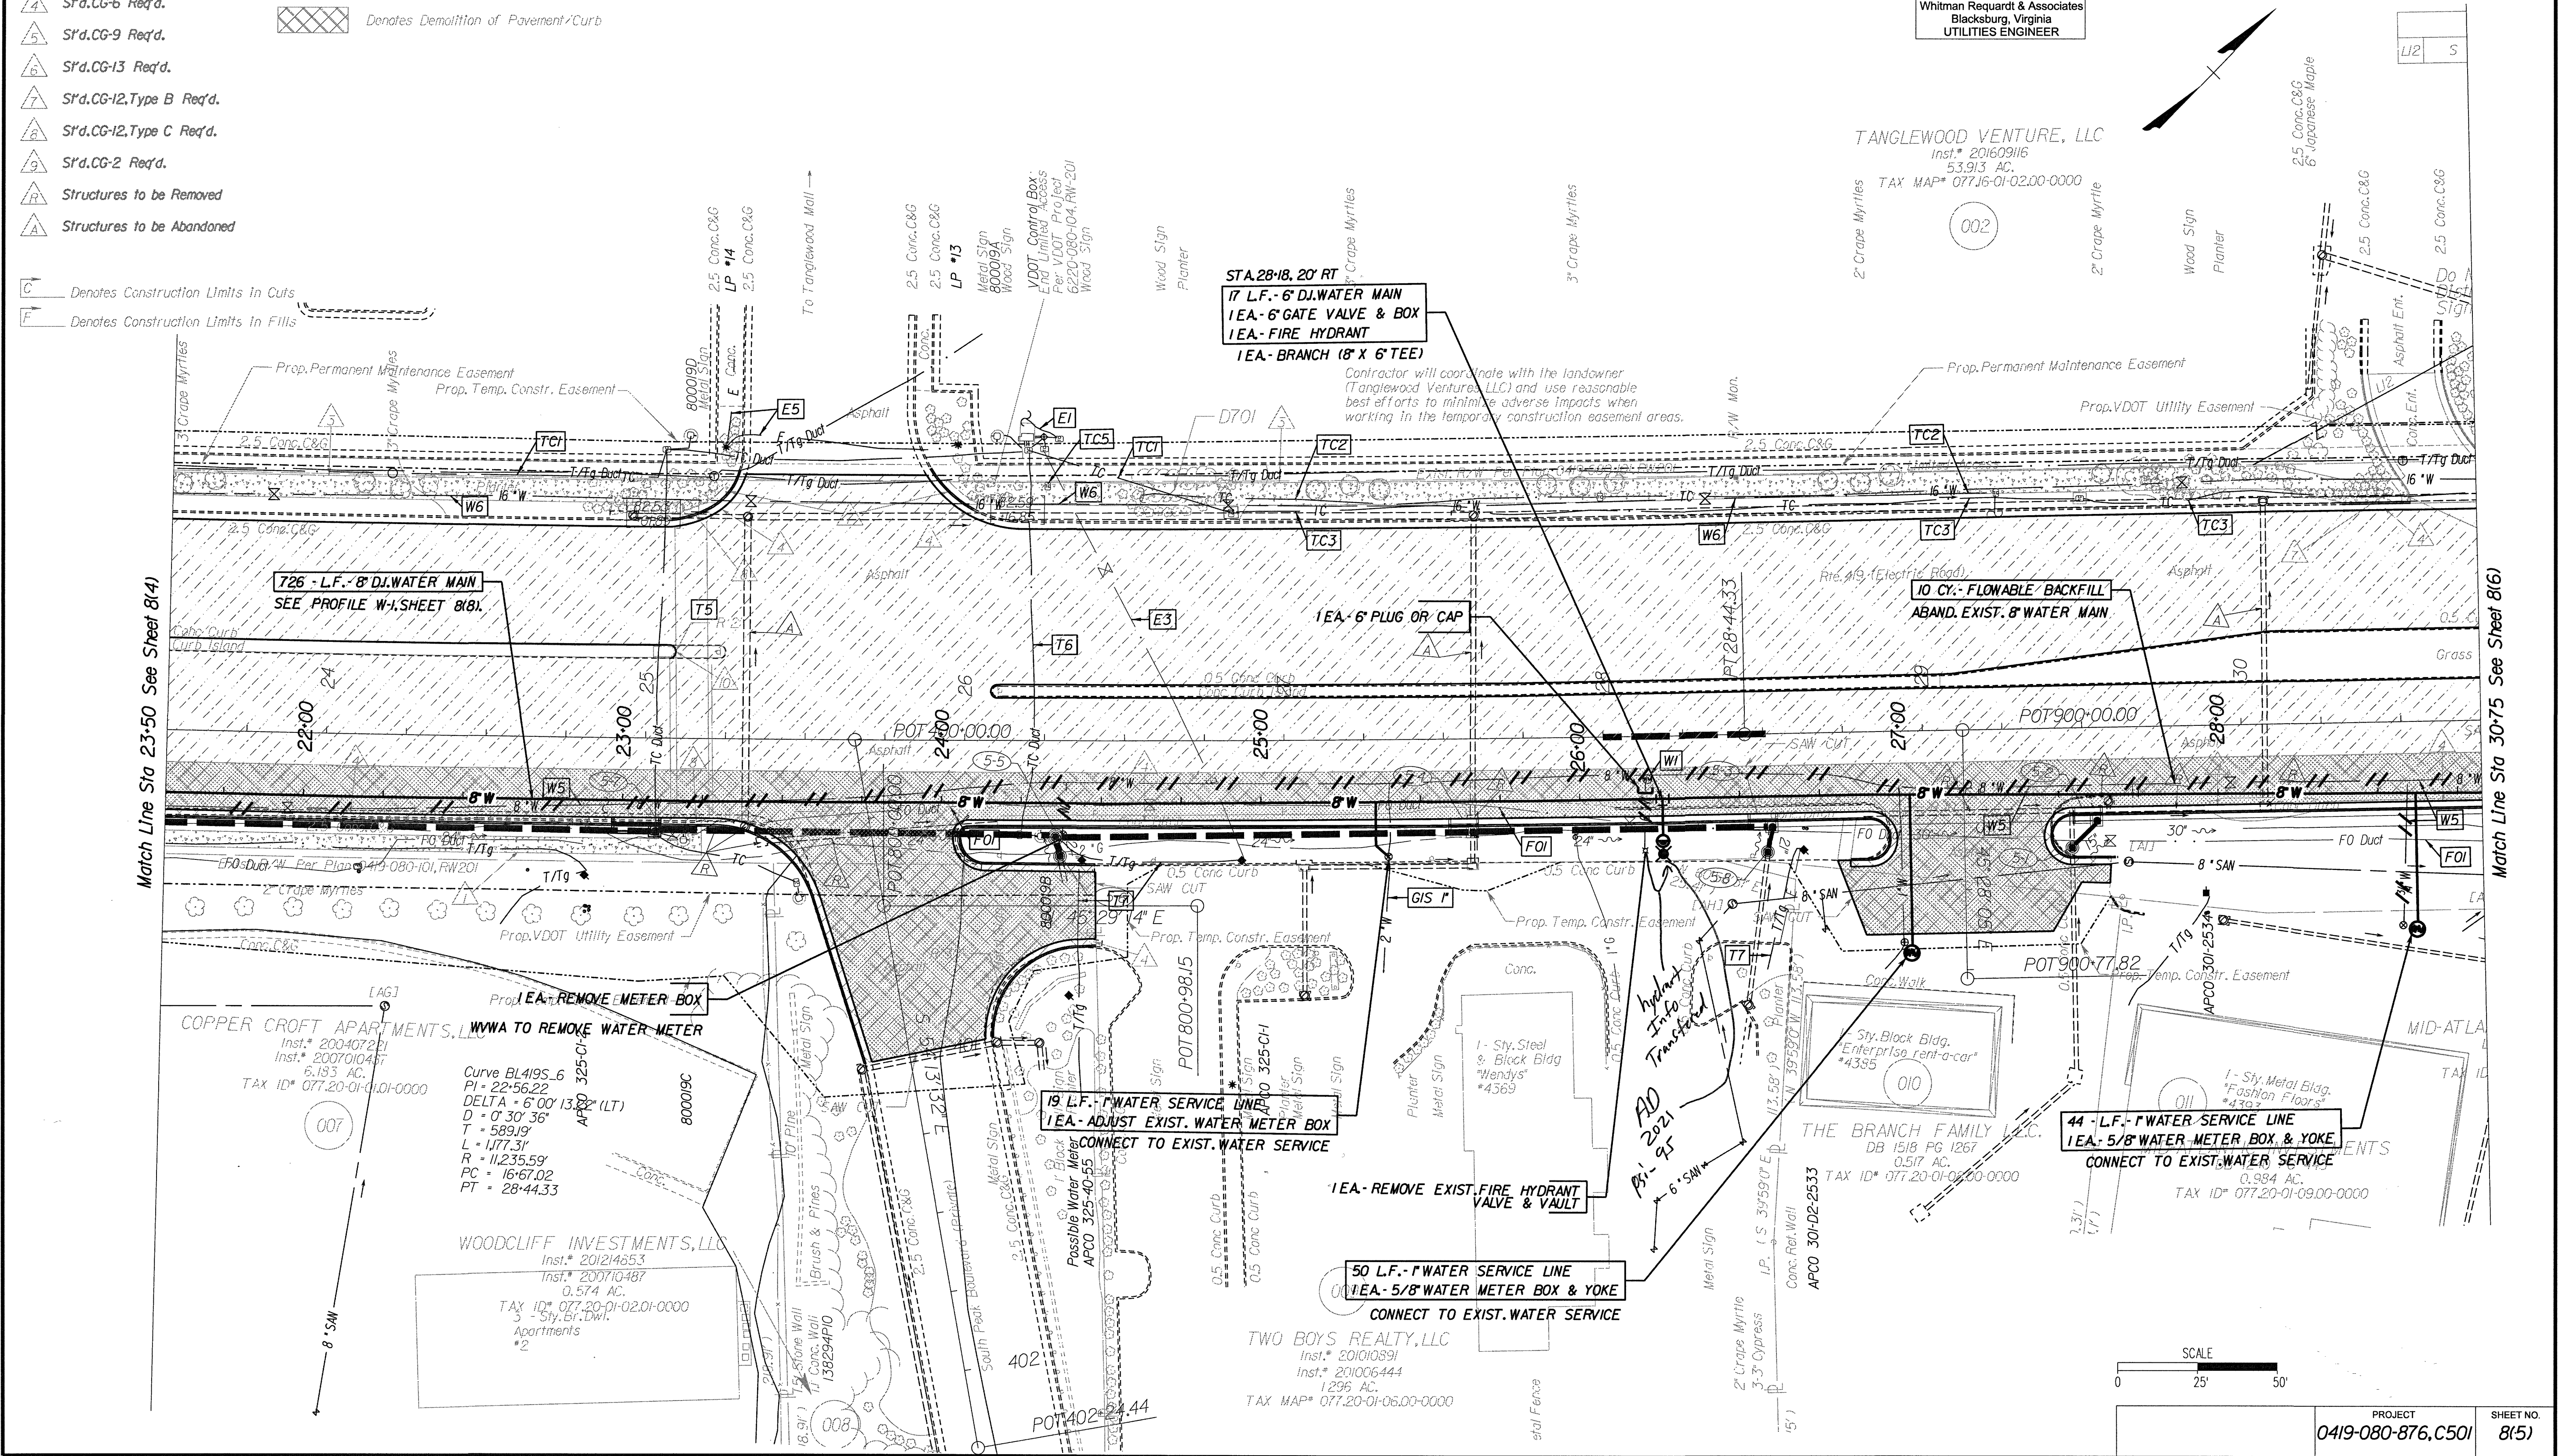

PROJECT	SHEET NO.
0419-080-876, C501	8(5)

THIS SHEET FOR UTILITY ADJUSTMENT/RELOCATION ONLY