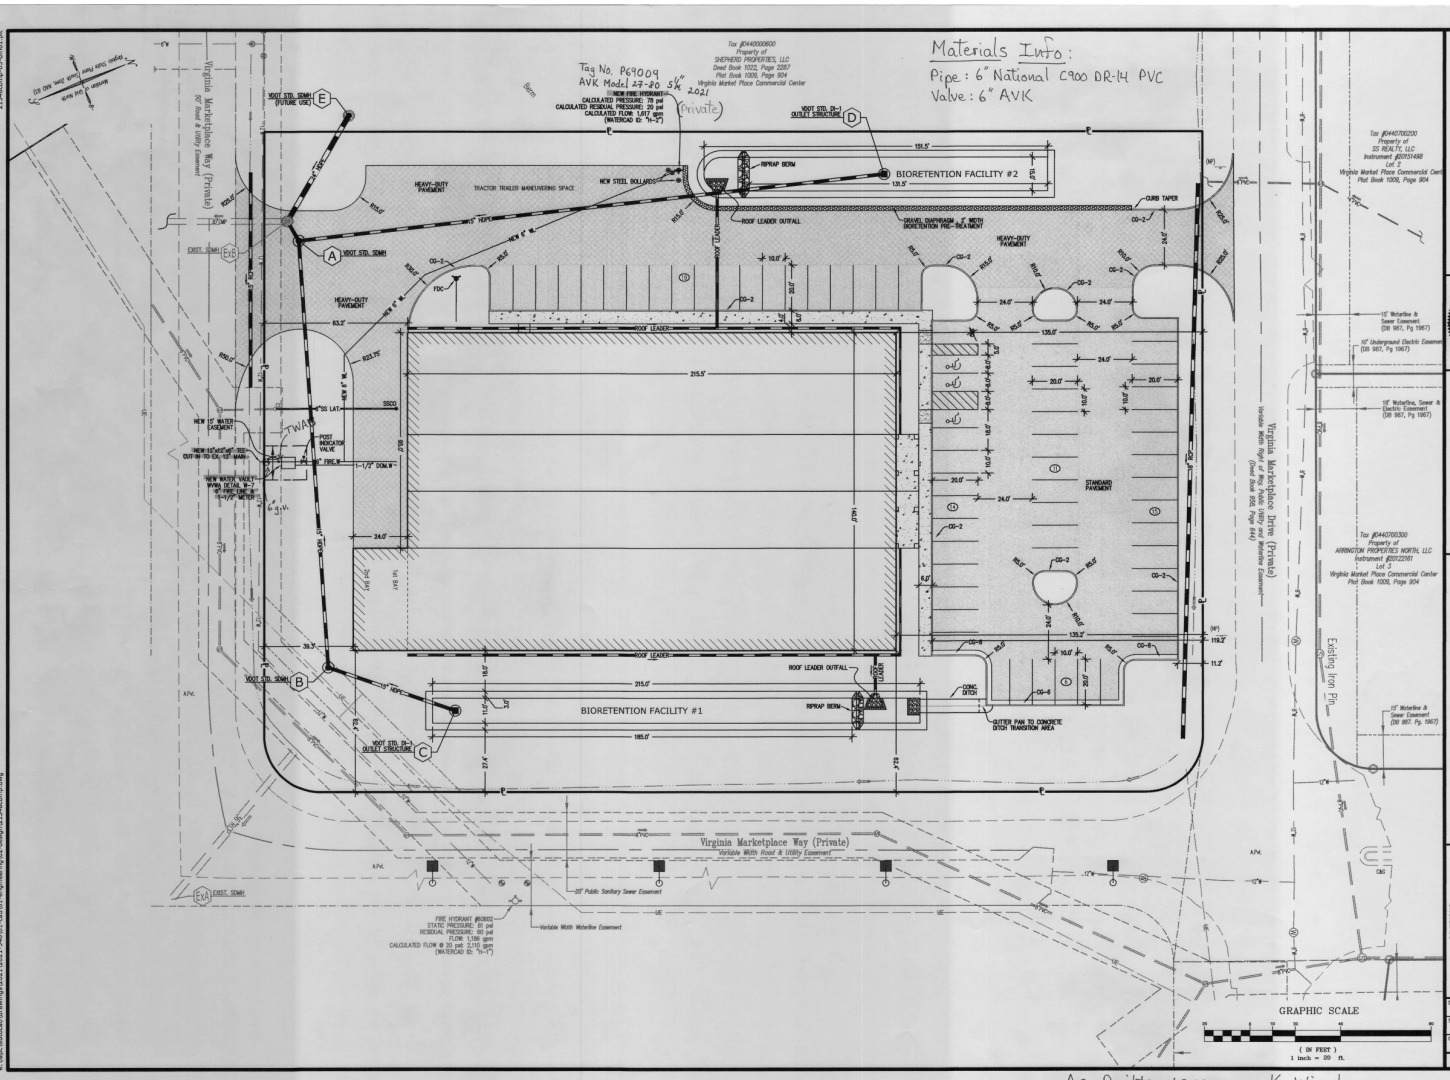

As-Built 10.19.22 K. Winslow

Lumsden Associates, P.C.
ENGINEERS | SURVEYORS | PLANNERS
PHONE: (540) 776-4411
FAX: (540) 776-4412
WWW.LUMSDENPC.COM
4664 BRAMBLETON AVENUE
SUITE 100
ROANOKE, VIRGINIA 24018

STATE OF VIRGINIA
HOWARD P. HOGGARD, III
Lic. No. 0001020
4-1-22
LANDSCAPE ARCHITECT

DIMENSIONAL LAYOUT

NEW RETAIL STORE SITE PLAN for
Virginia Furniture Market
PREPARED FOR
SHEPHERD PROPERTIES, LLC
VIRGINIA MARKET PLACE DRIVE
FRANKLIN COUNTY, VIRGINIA

REVISIONS		
NO.	DATE	DESCRIPTION
1		
2		
3		
4		
5		

DATE: April 7, 2022
SCALE: 1" = 20'
COMMISSION NO: 2021-348
SHEET 3 OF 11