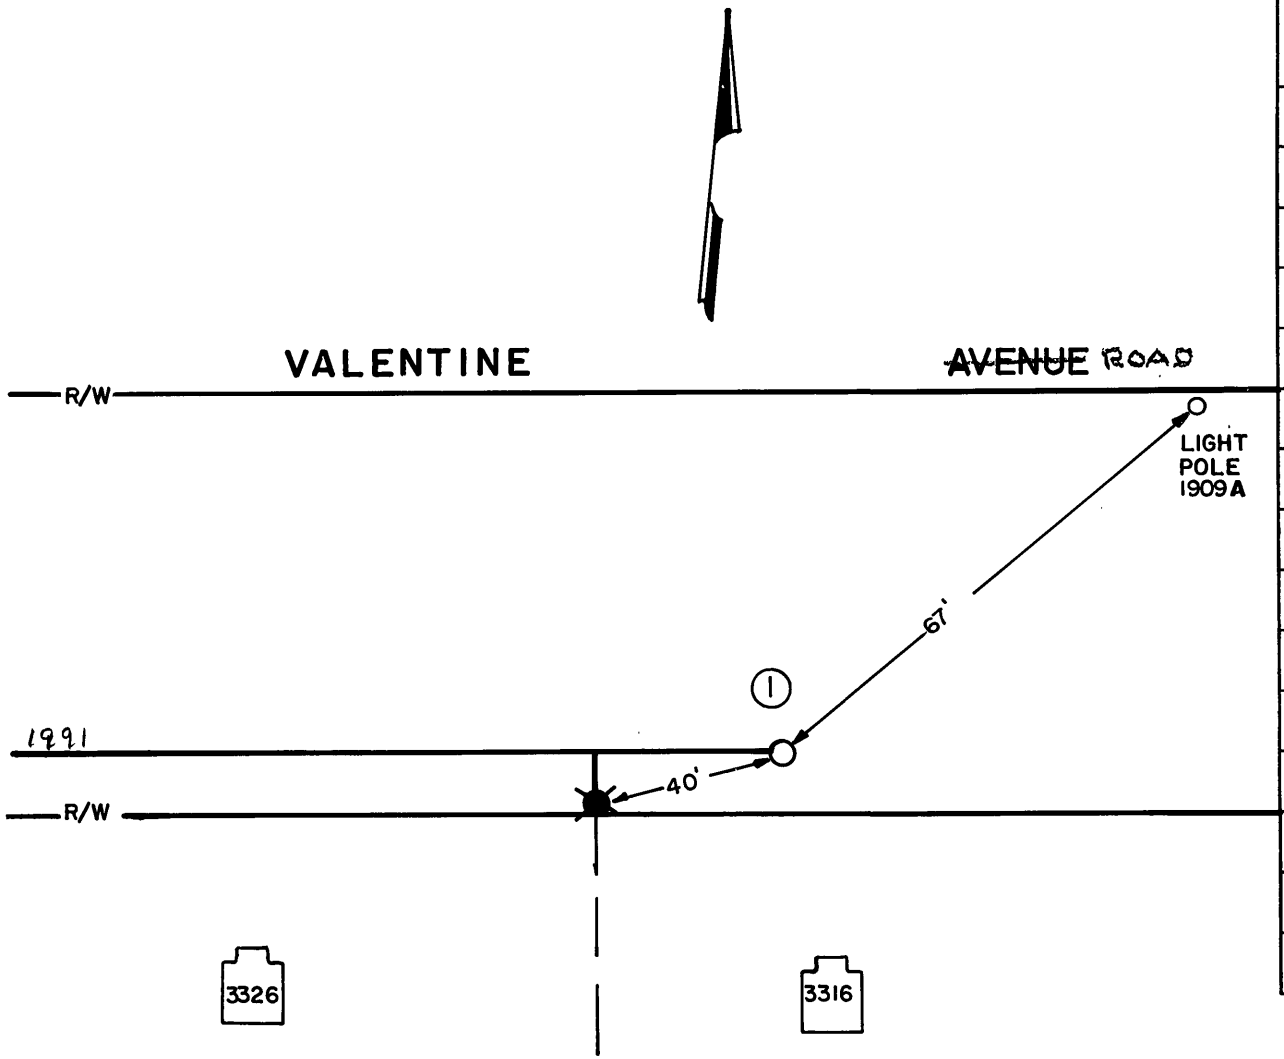

DATE	NO.	SIZE	MAKE	OPEN	TURNS
1991	1	2"	BLOW OFF		

CITY OF ROANOKE—WATER DEP'T

VALVE DIAGRAM

3316 VALENTINE ~~AVE.~~ RD

SEC. MAP 505 S.W.

DATE PAGE NO.

10/91 NP