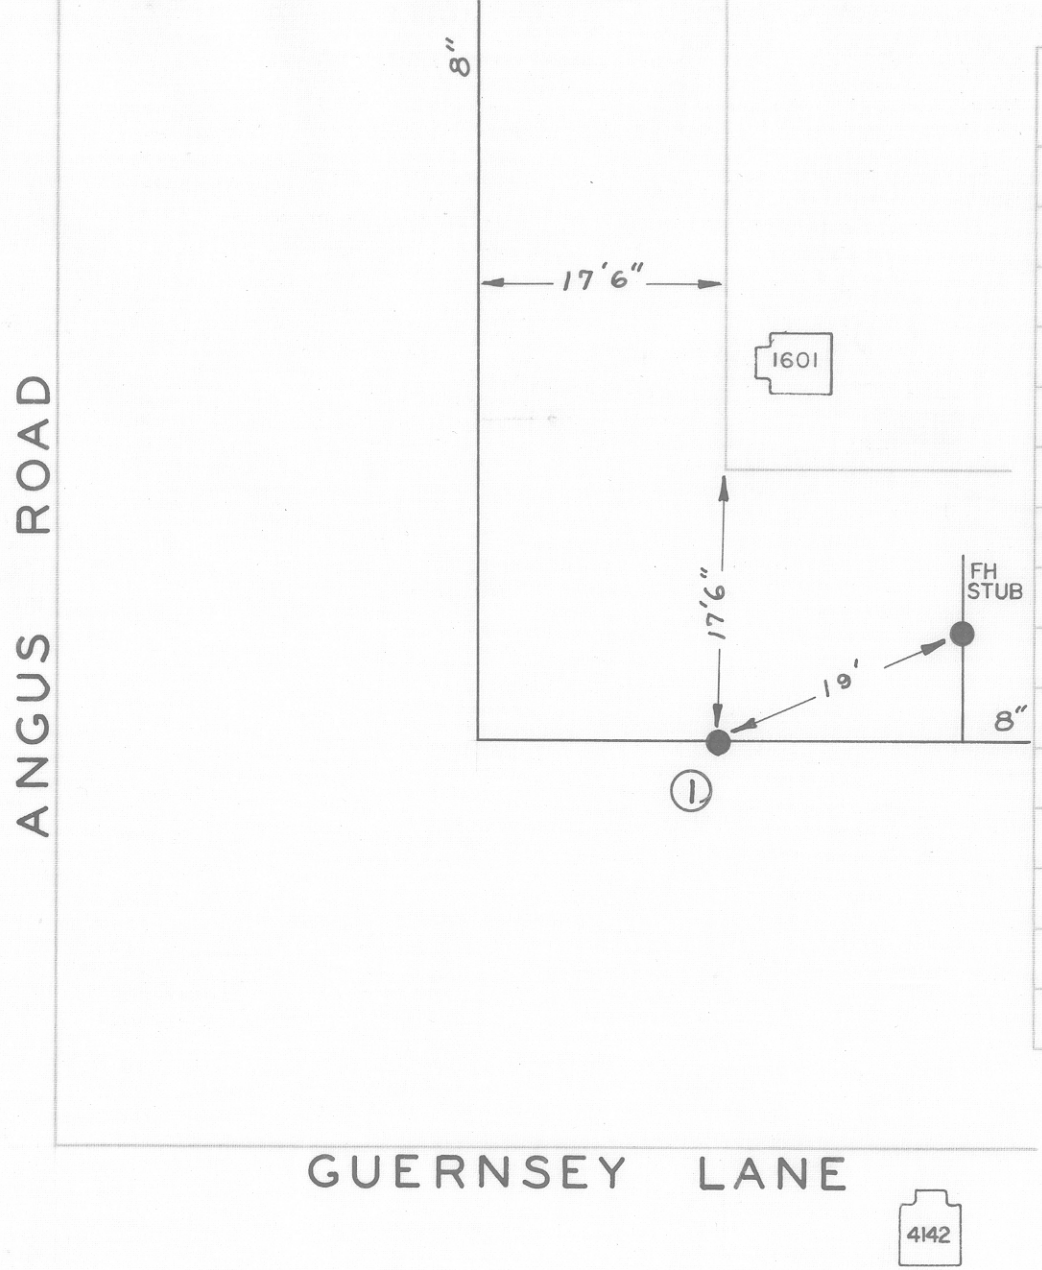

DATE	NO.	SIZE	MAKE	OPEN	TURNS
'58	1	8"	DARLING	R	
	1	0	EPL		

CITY OF ROANOKE—WATER DEP'T

VALVE DIAGRAM

ANGUS ROAD &

GUERNSEY LANE N.W.

SEC. MAP 638

DATE PAGE NO.

2/87 NP