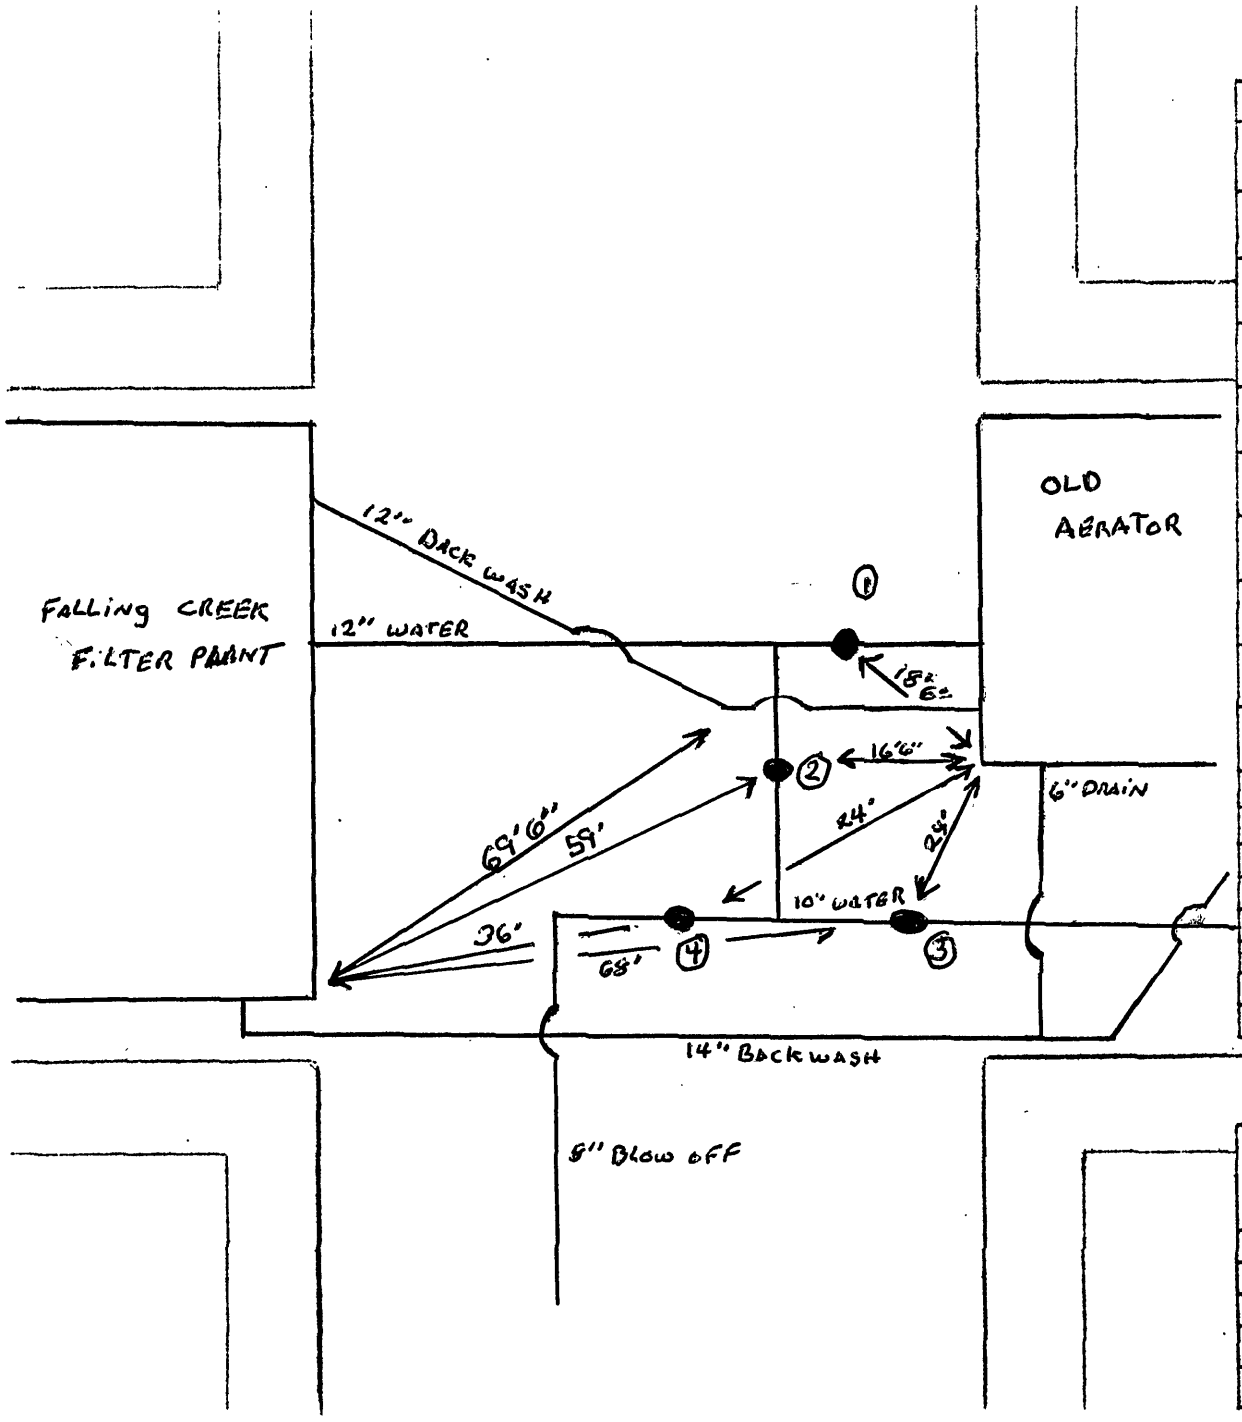

DATE	NO.	SIZE	MAKE	OPEN	TURNS
1983	1	12"	MULL	R	39
	2	10"		L	33
8/91	3	10"	DARLING	R	33
8/91	4	8"	MULL	R	27

P. L. Measurements

No.	Distance	Direction

CITY OF ROANOKE - WATER DEPT.

VALVE DIAGRAM

FALLING CREEK FILTER PLANT

Sec. Map

Date 8-24-91 Page No.