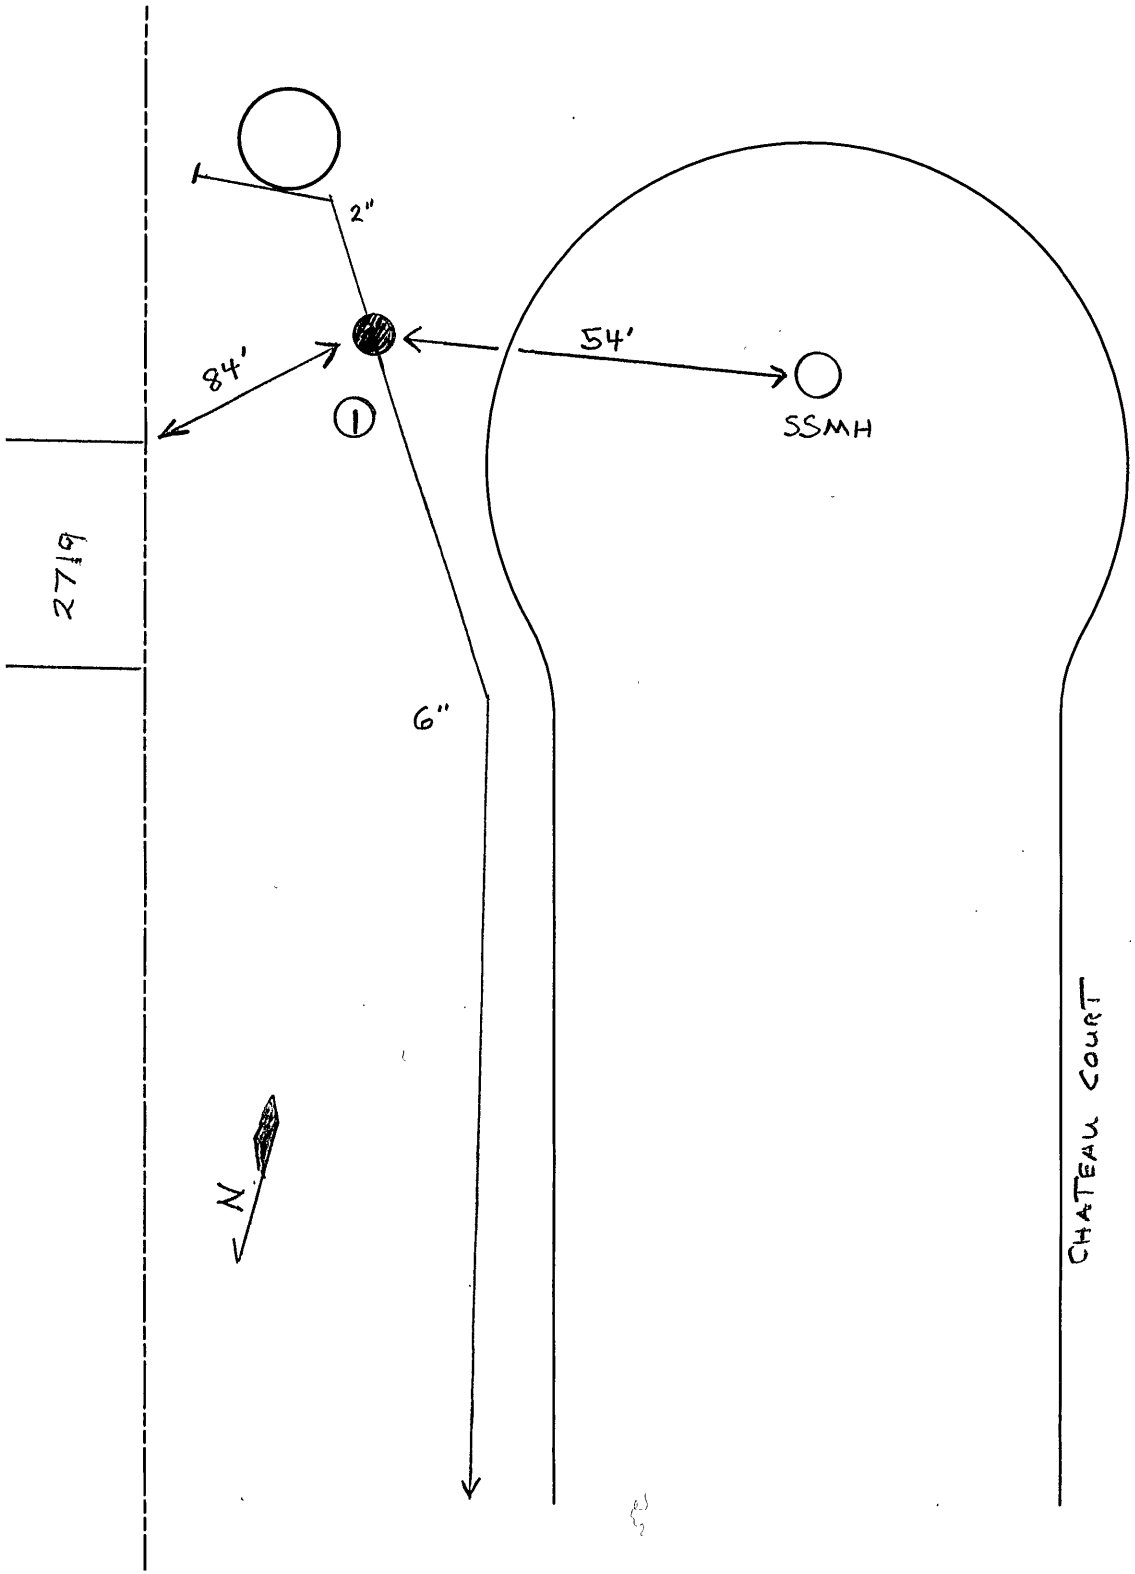

DATE	NO.	SIZE	MAKE	OPEN	TURNS
2004	1	2"	Blowoff	L	7

WESTERN VIRGINIA WATER AUTHORITY

VALVE DIAGRAM

2719 CHATEAU COURT

East End

SECT. MAP County

DATE 8-18-04