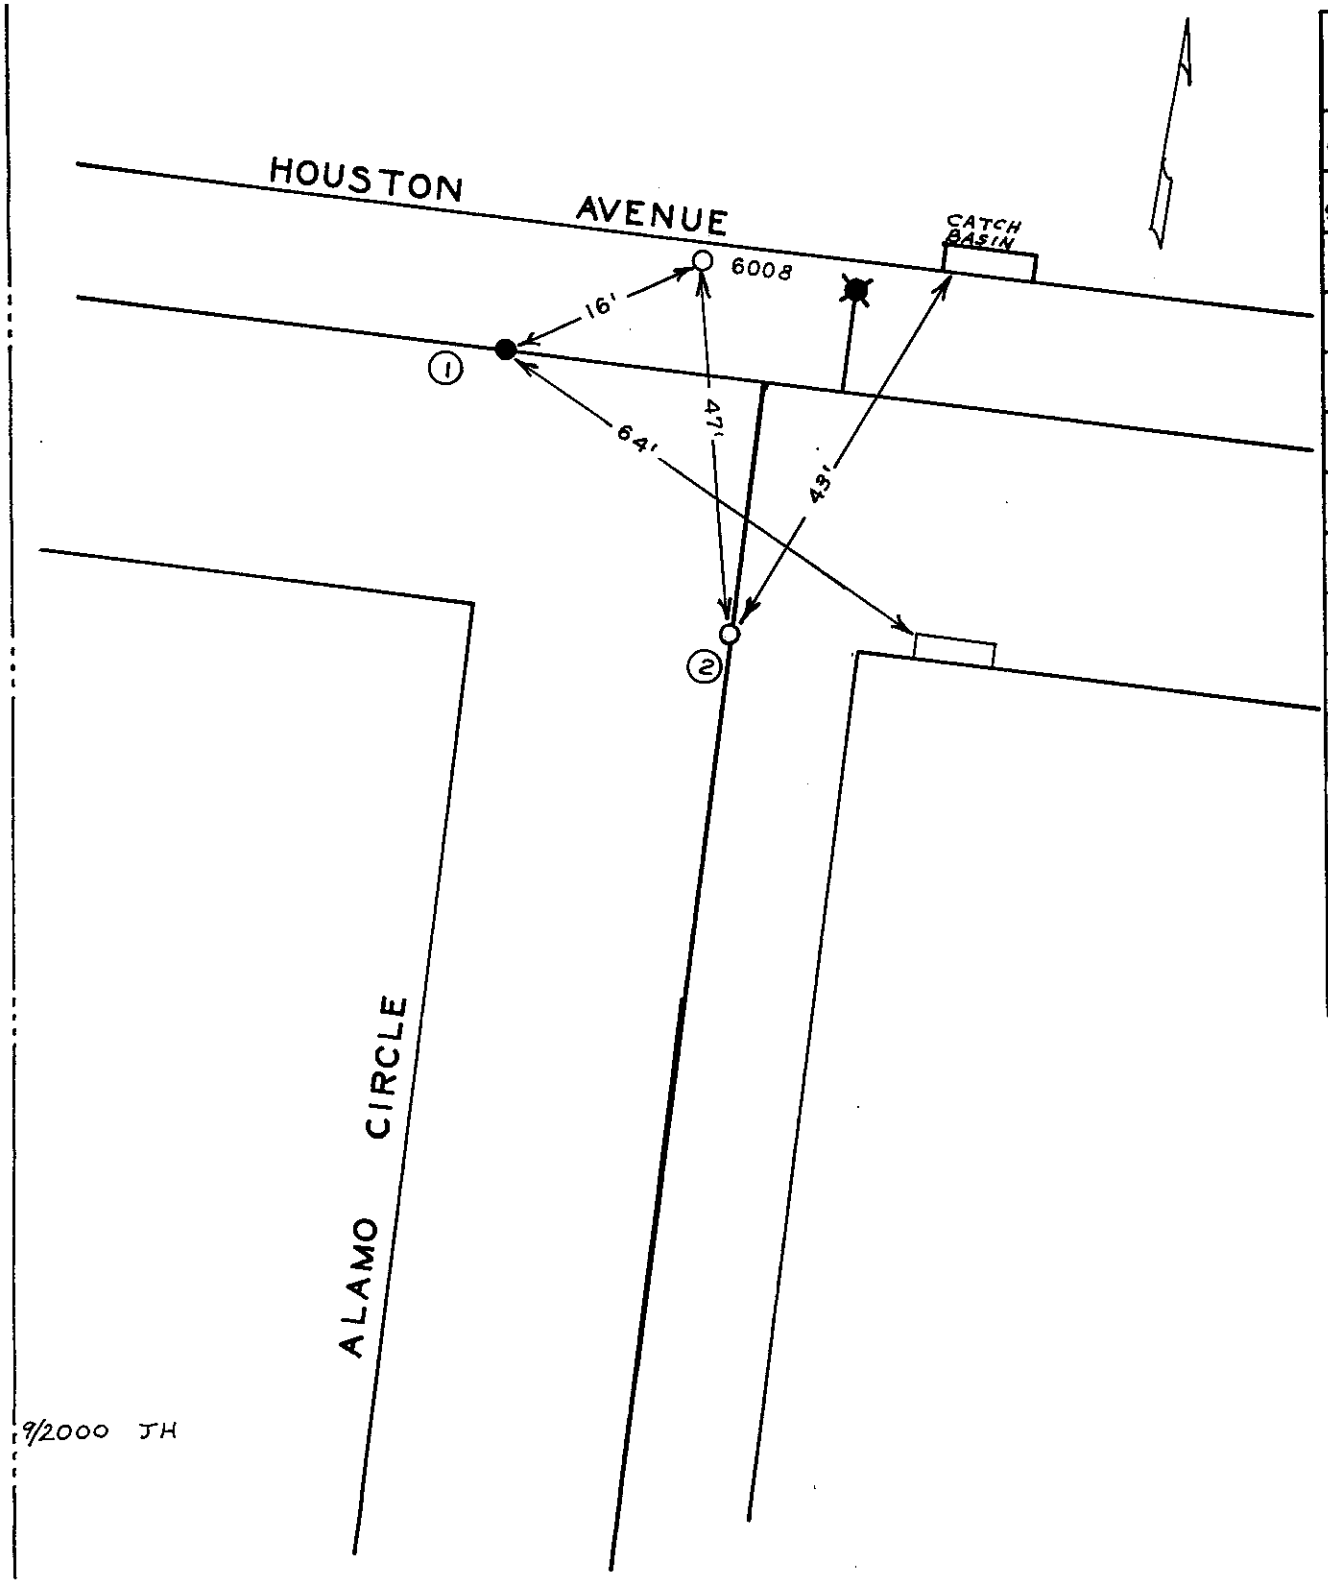

DATE	NO.	SIZE	MAKE	OPEN	TURNS
9-66	1	6"	MUELLER	R	
9-66	2	2"	DARLING	R	

CITY OF ROANOKE—WATER DEPT.

VALVE DIAGRAM

ALAMO CIRCLE &

HOUSTON AVENUE N.E.

SEC. MAP 320 , 330

DATE **PAGE NO.**

9/2000 JH