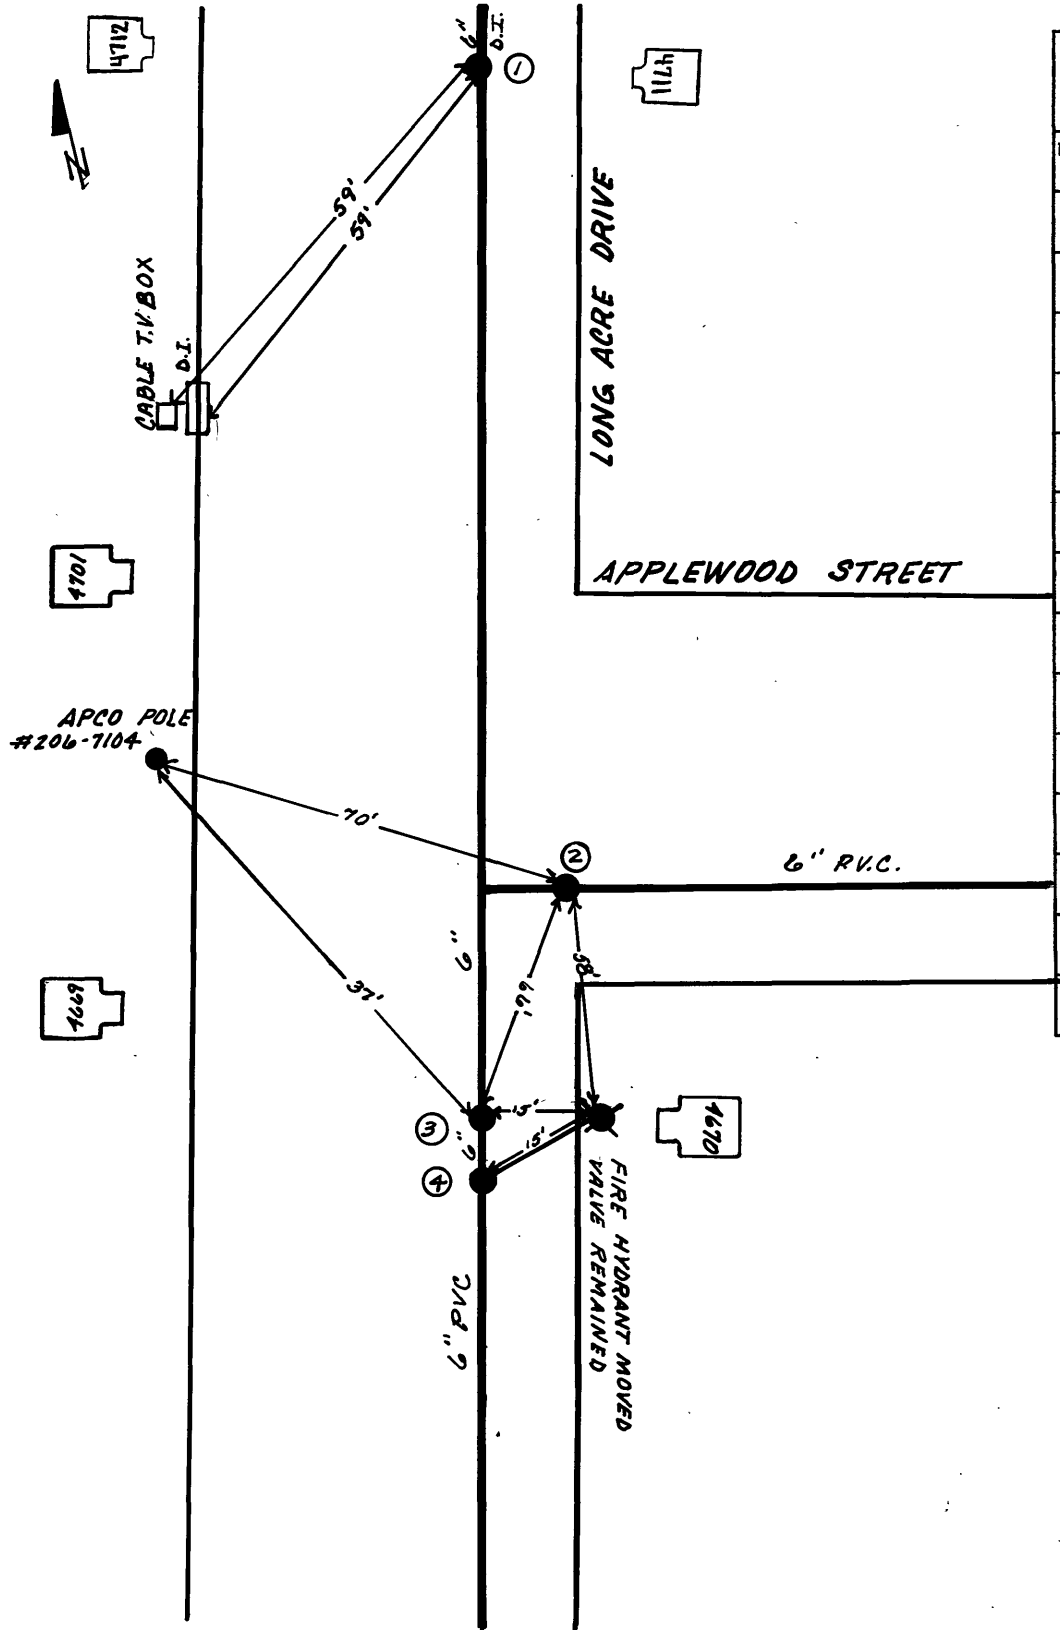


| DATE | NO. | SIZE | MAKE | OPEN | TURNS |
|---|---|---|---|---|---|
| M.H. 1980 | 1 | 6" | | | |
| M.H. 1980 | 2 | 6" | | | |
| M.H. 1980 | 3 | 6" | | | |
| M.H. 1980 | 4 | 6" | | | |
| | | | | | |
| | | | | | |
M.H.=Monterey Hills North Water System

**CITY OF ROANOKE—WATER DEP'T**

**VALVE DIAGRAM**

APPLEWOOD STREET AND

LONG ACRE DRIVE N.E.

SEC. MAP 739 & 740

DATE JULY 11, 1980 PAGE NO.