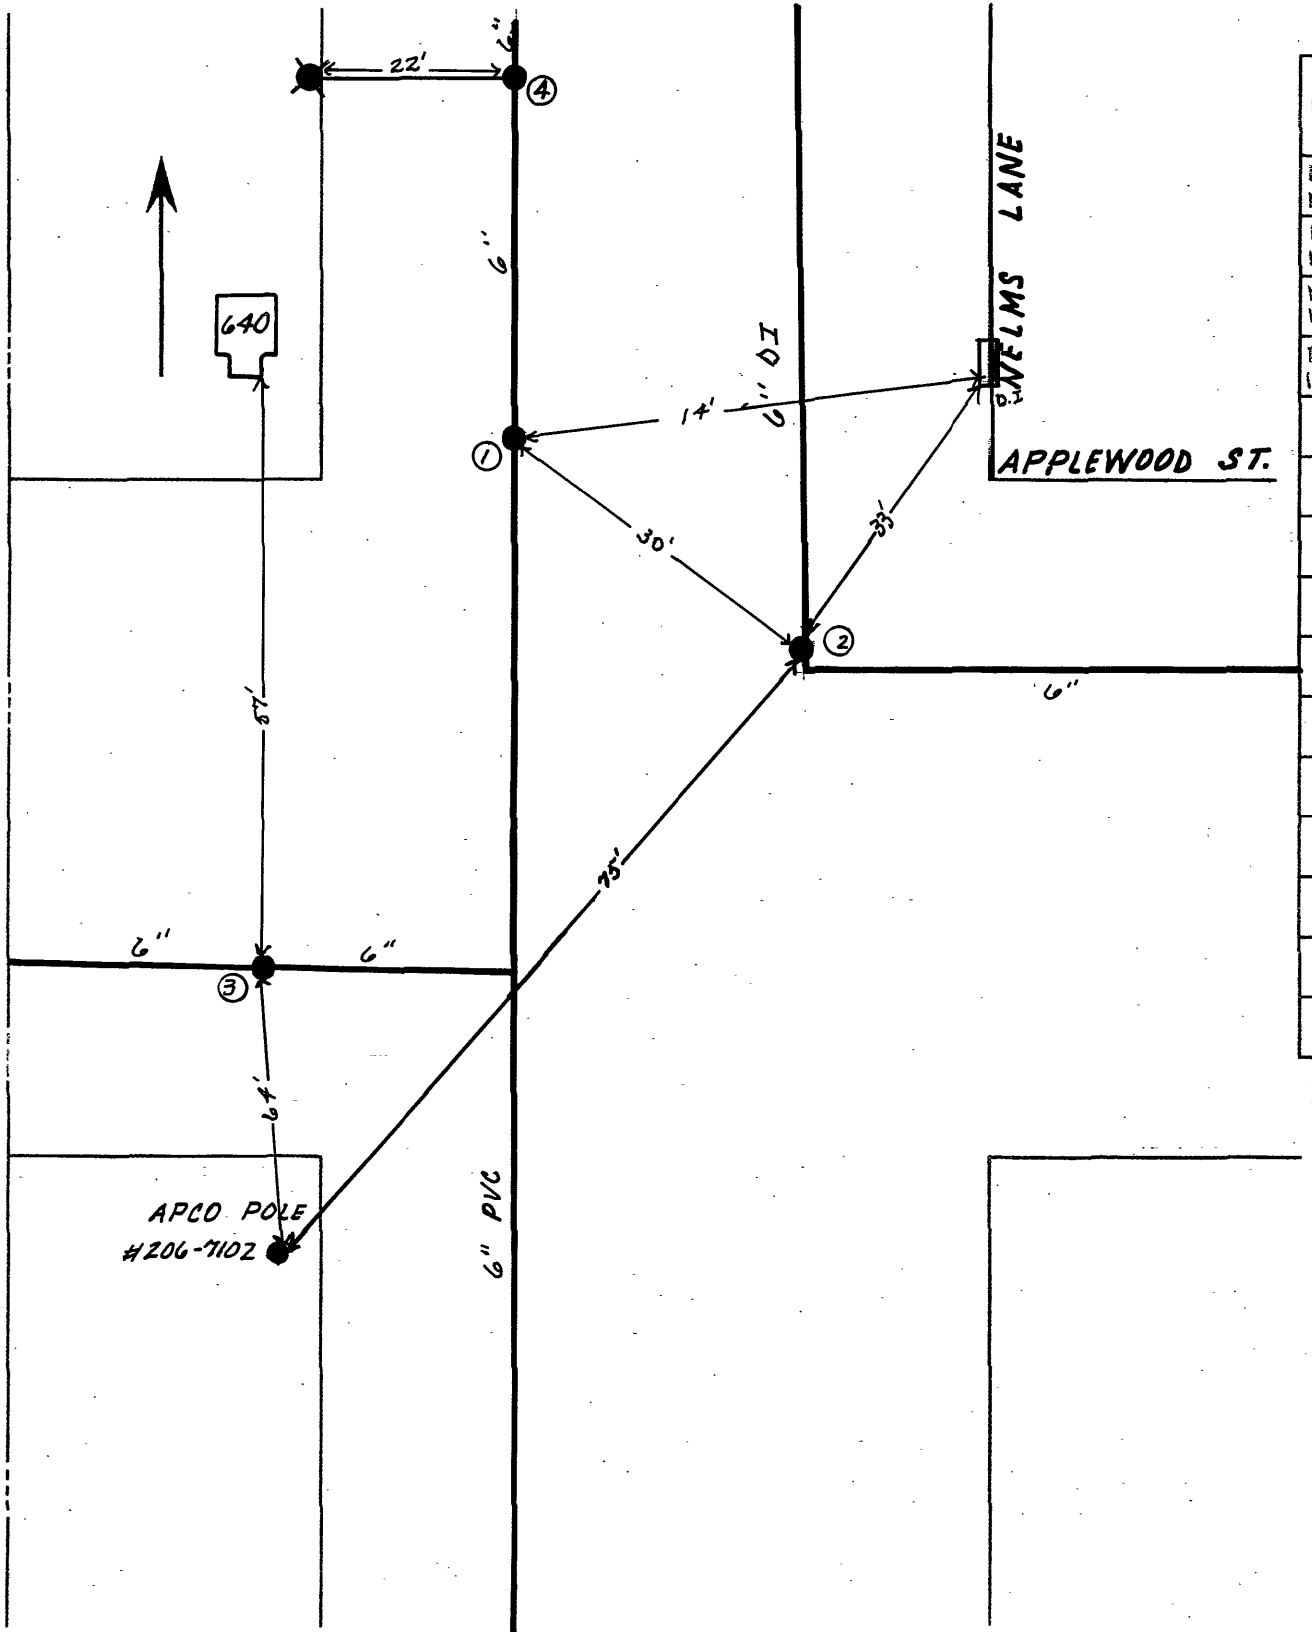

DATE	NO.	SIZE	MAKE	OPEN	TURNS
M.H. 1980	1	6"			
M.H. 1980	2	6"			
M.H. 1980	3	6"			
M.H. 1980	4	6"			


CITY OF ROANOKE—WATER DEP'T

VALVE DIAGRAM

APPLEWOOD STREET AND

NELMS LANE N.E.

SEC. MAP 739

DATE JULY 11, 1980 PAGE NO.