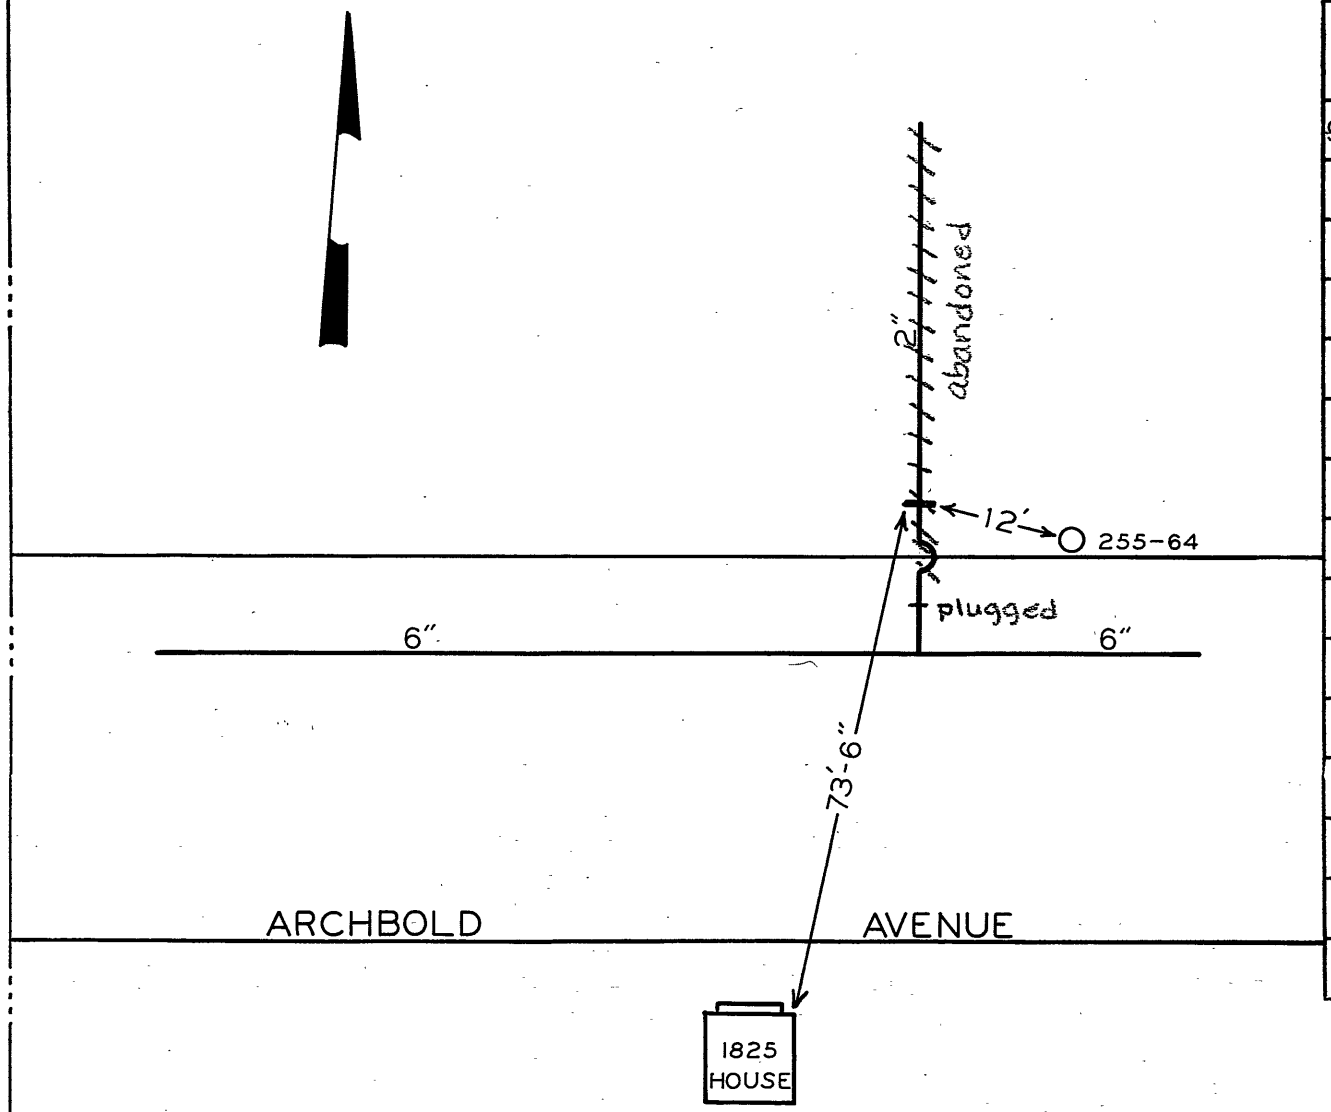

DATE	NO.	SIZE	MAKE	OPEN	TURNS
~~9-68~~	~~1~~	~~2"~~	~~MISC.~~	~~L~~	

CITY OF ROANOKE—WATER DEPT.

VALVE DIAGRAM

ARCHBOLD AVE. N.E.

IN FRONT OF 1825

SEC. MAP 322

DATE **PAGE NO.**