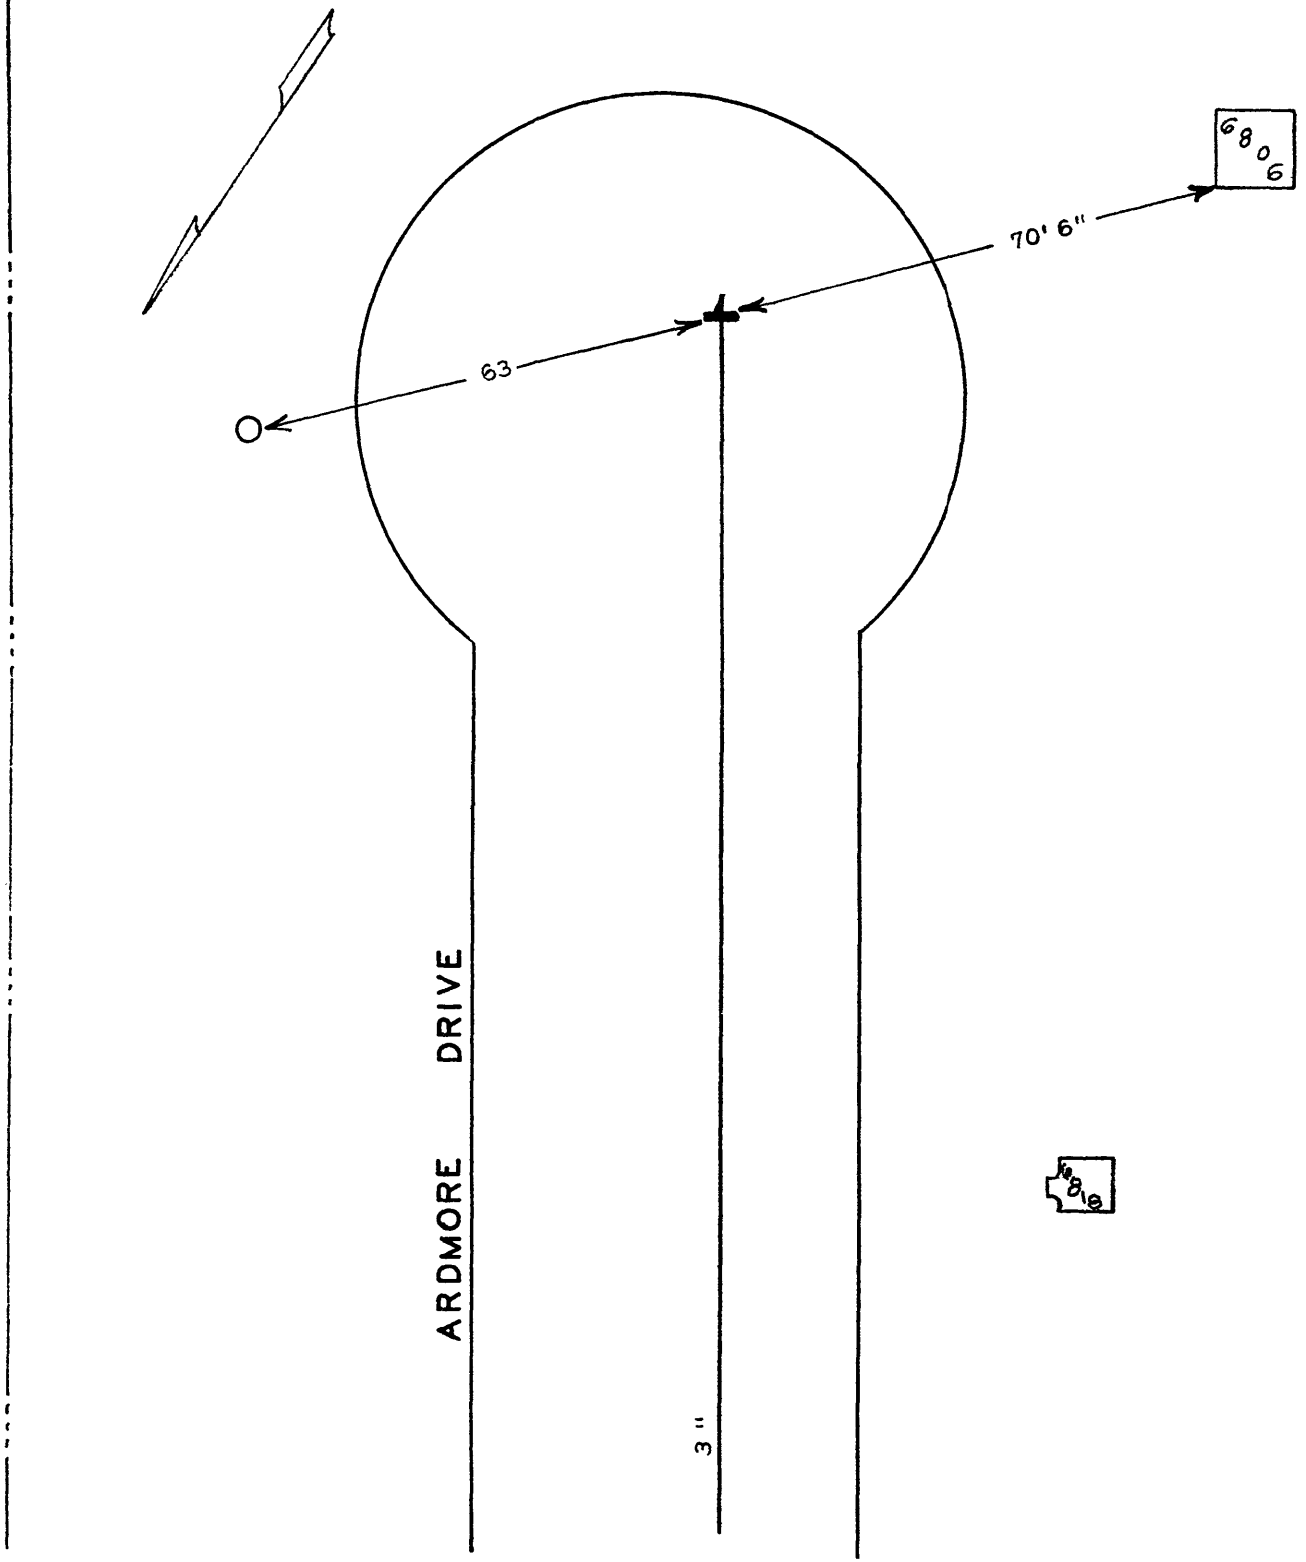

DATE	NO.	SIZE	MAKE	OPEN	TURNS
10-66	1	1"	MISC.	L	7

CITY OF ROANOKE—WATER DEPT.

VALVE DIAGRAM

ARDMORE DRIVE N.E.

SEC. MAP 58 Roanoke County

DATE PAGE NO.