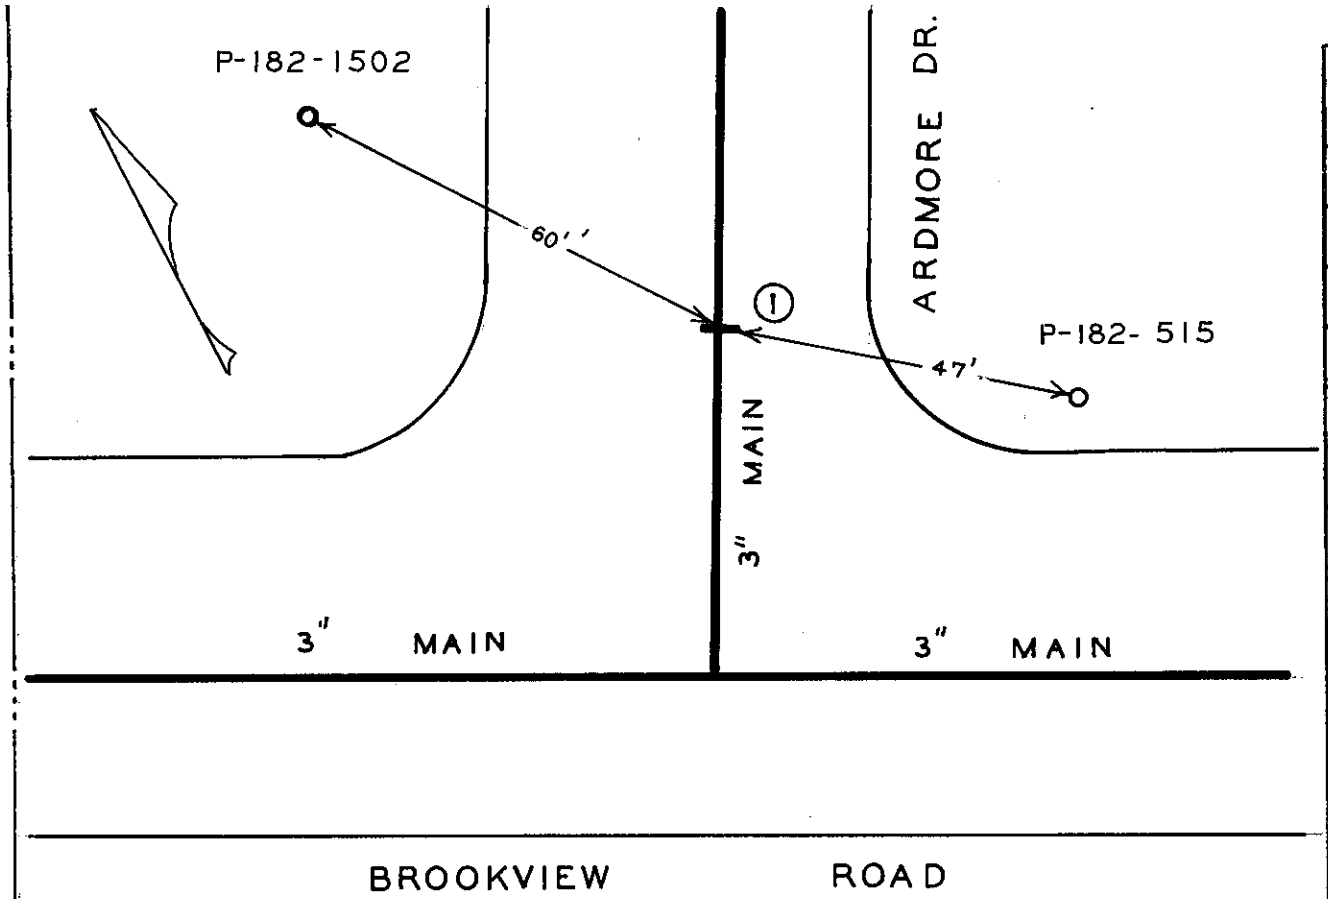

DATE	NO.	SIZE	MAKE	OPEN	TURNS
	1	3"		L	11

CITY OF ROANOKE—WATER DEPT.

VALVE DIAGRAM

ARDMORE DR. &

BROOKVIEW RD. N.E.

SEC. MAP 58 Roanoke County

DATE 9-7-66 **PAGE NO.**