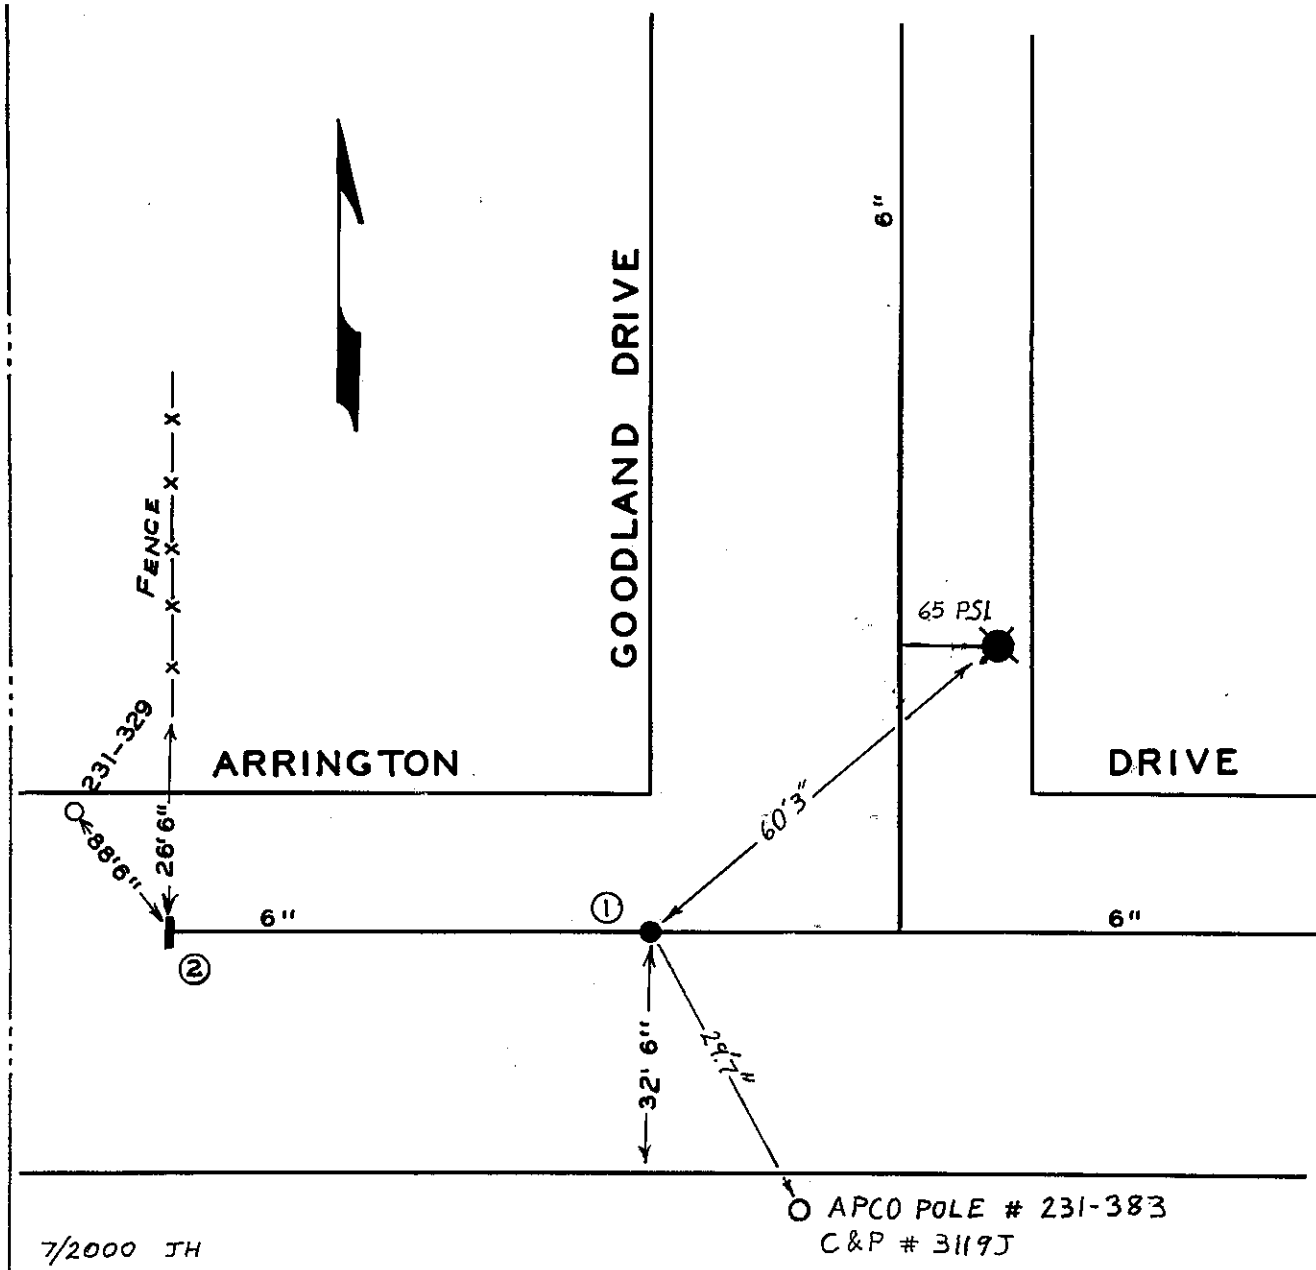


| DATE | NO. | SIZE | MAKE | OPEN | TURNS |
|---|---|---|---|---|---|
| '60 | 1 | 6" | MUELLER | R | 20½ |
| 9-63 | 2 | 2" | MISC. | L | |
| | | | | | |
| | | | | | |
| | | | | | |
| | | | | | |
| | | | | | |
| | | | | | |
| | | | | | |
| | | | | | |
| | | | | | |
| | 1 | 0 | W.P.L. | | |
| | | | | | |
| | | | | | |
| | | | | | |

**CITY OF ROANOKE—WATER DEPT.**

**VALVE DIAGRAM**

ARRINGTON DRIVE &
GOODLAND DRIVE N.E.

SEC. MAP 707

DATE PAGE NO.