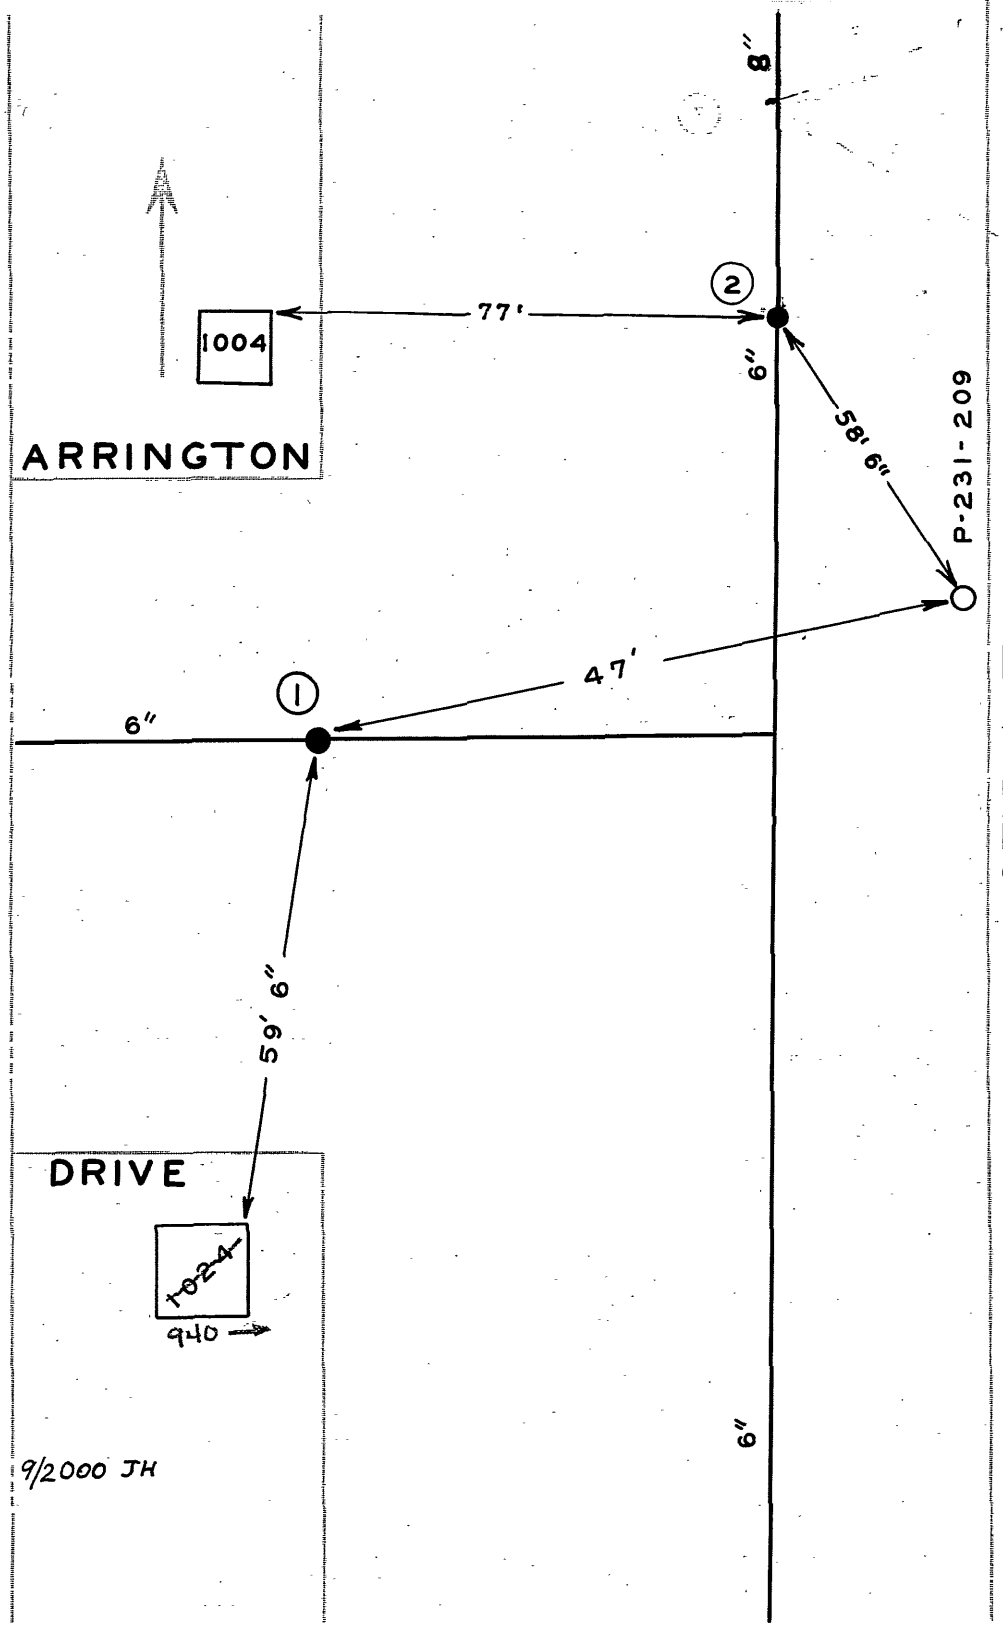

DATE	NO.	SIZE	MAKE	OPEN	TURNS
'60	1	6"	MUE.	R	20½
7-65	2	6"	DARLING	R	
	1	0	WPL		
	2	60'N	N. P. L.		

CITY OF ROANOKE—WATER DEPT

VALVE DIAGRAM

ARRINGTON DR. &

MECCA ST. N. E.

SEC. MAP 707, 708, 709

DATE PAGE NO.