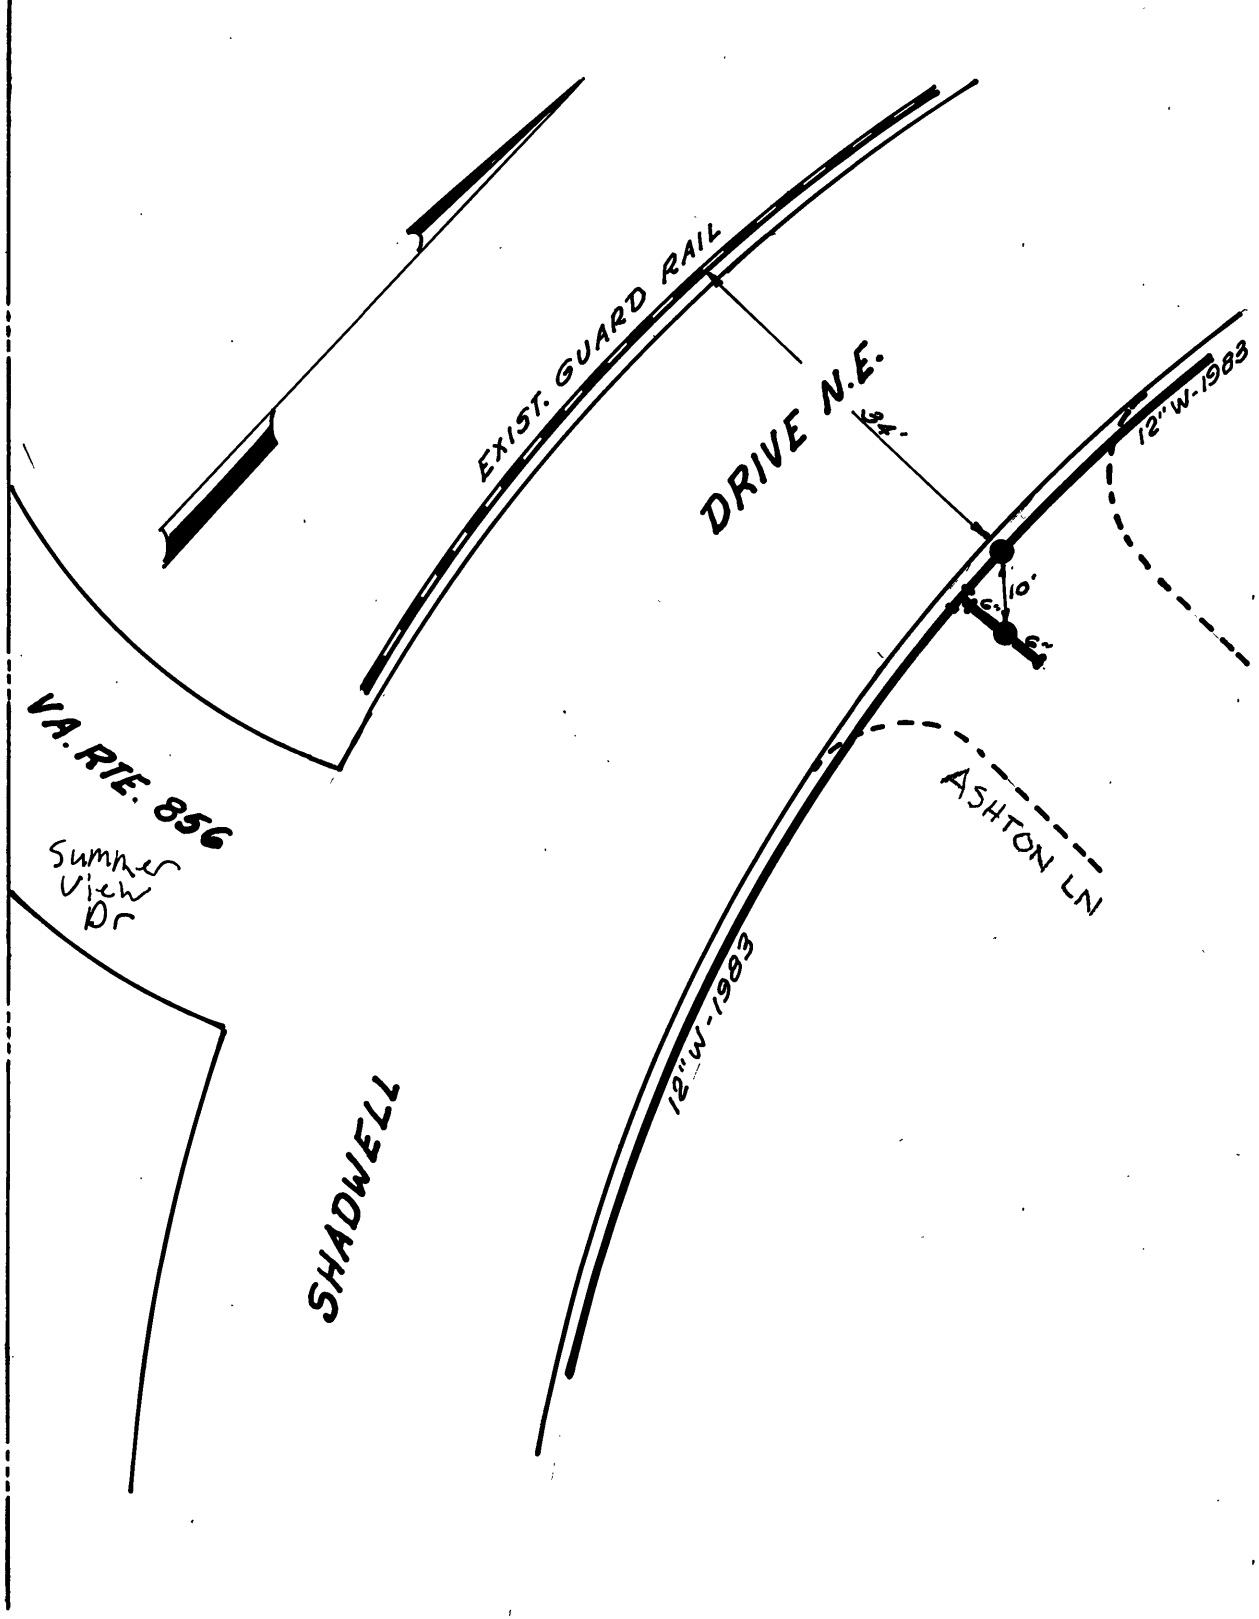

DATE	NO.	SIZE	MAKE	OPEN	TURNS
8-83	1	12	KENNEDY	R	39
8-83	2	6	MULLER	R	21

CITY OF ROANOKE—WATER DEP'T

VALVE DIAGRAM

ASHTON LN

SHADWELL DRIVE N.E.

~~AT VA. SEC. RTE. 856~~

SEC. MAP Summer View Dr

DATE PAGE NO.