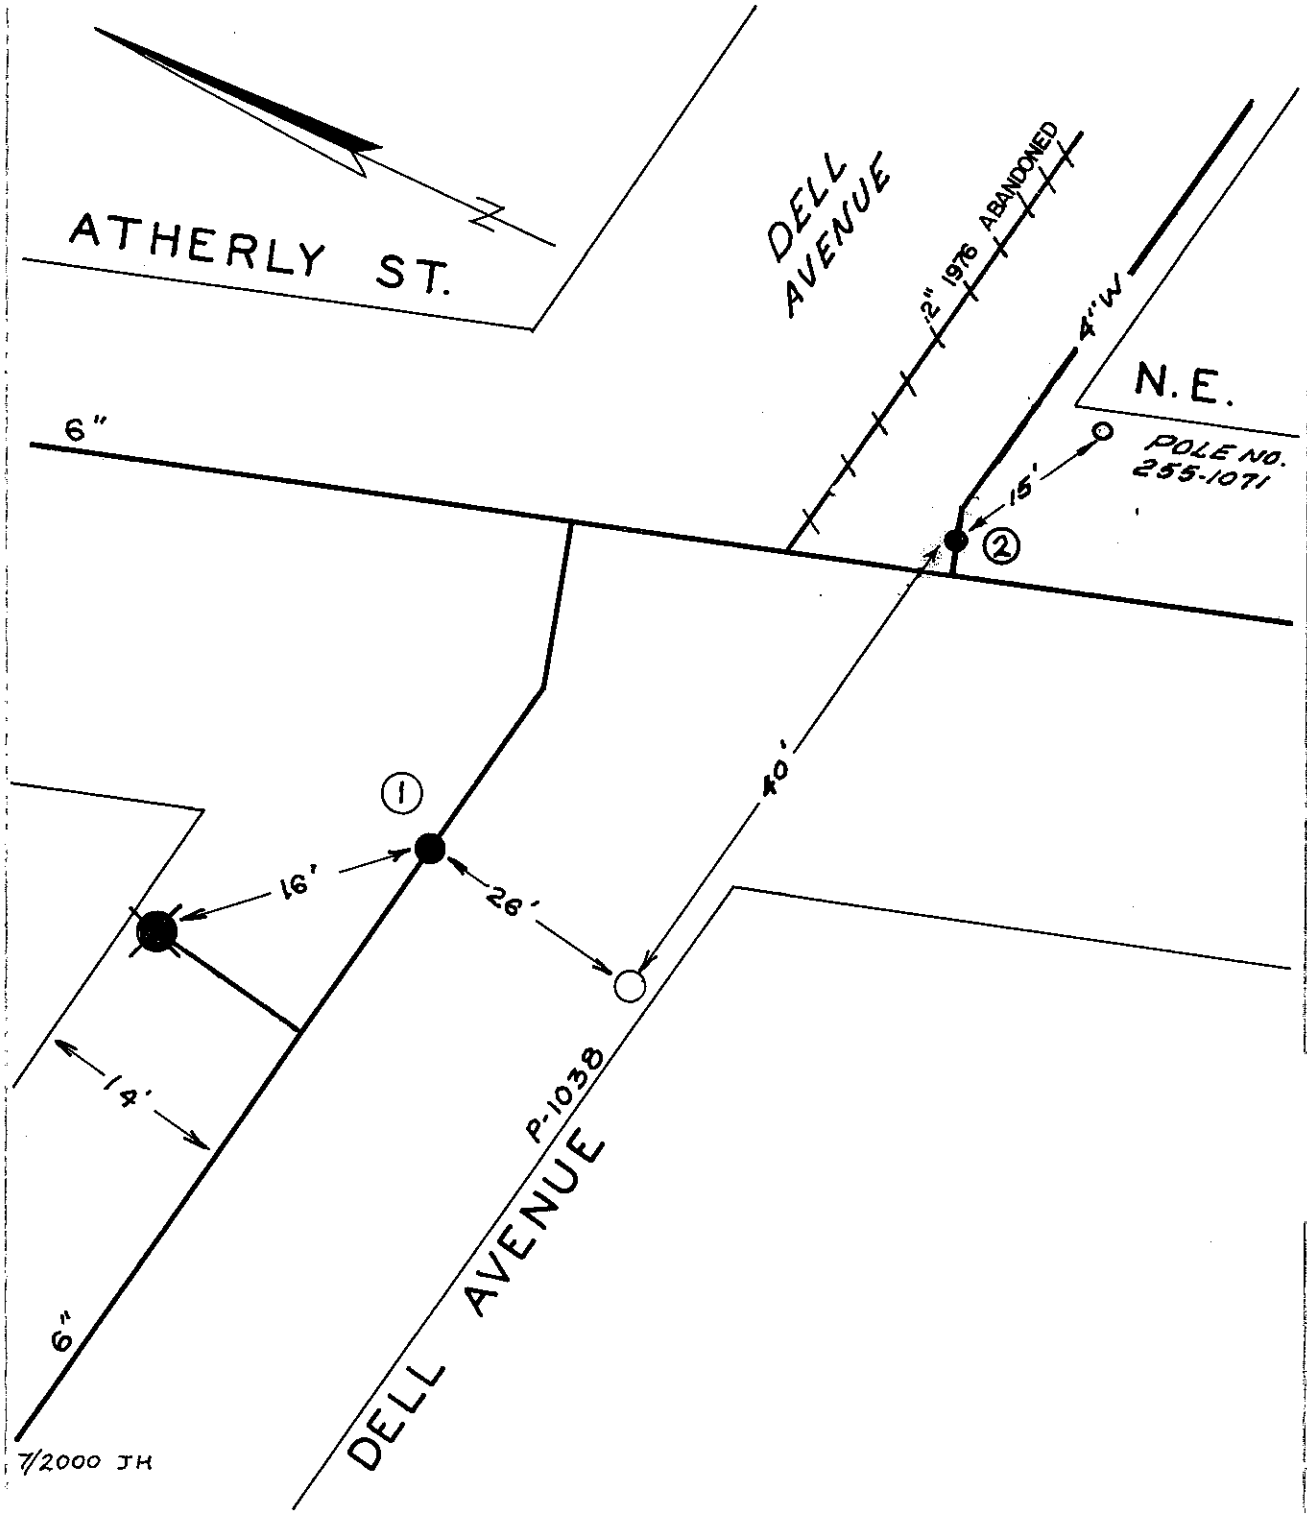

DATE	NO.	SIZE	MAKE	OPEN	TURNS
1951	1	6"			
8-83	2	4"	DARL.	R	15
	1	0	WPL		

CITY OF ROANOKE – WATER DEPT.

VALVE DIAGRAM

ATHERLY ST. & DELL AVENUE N.E.

SEC. MAP 341

DATE PAGE NO.