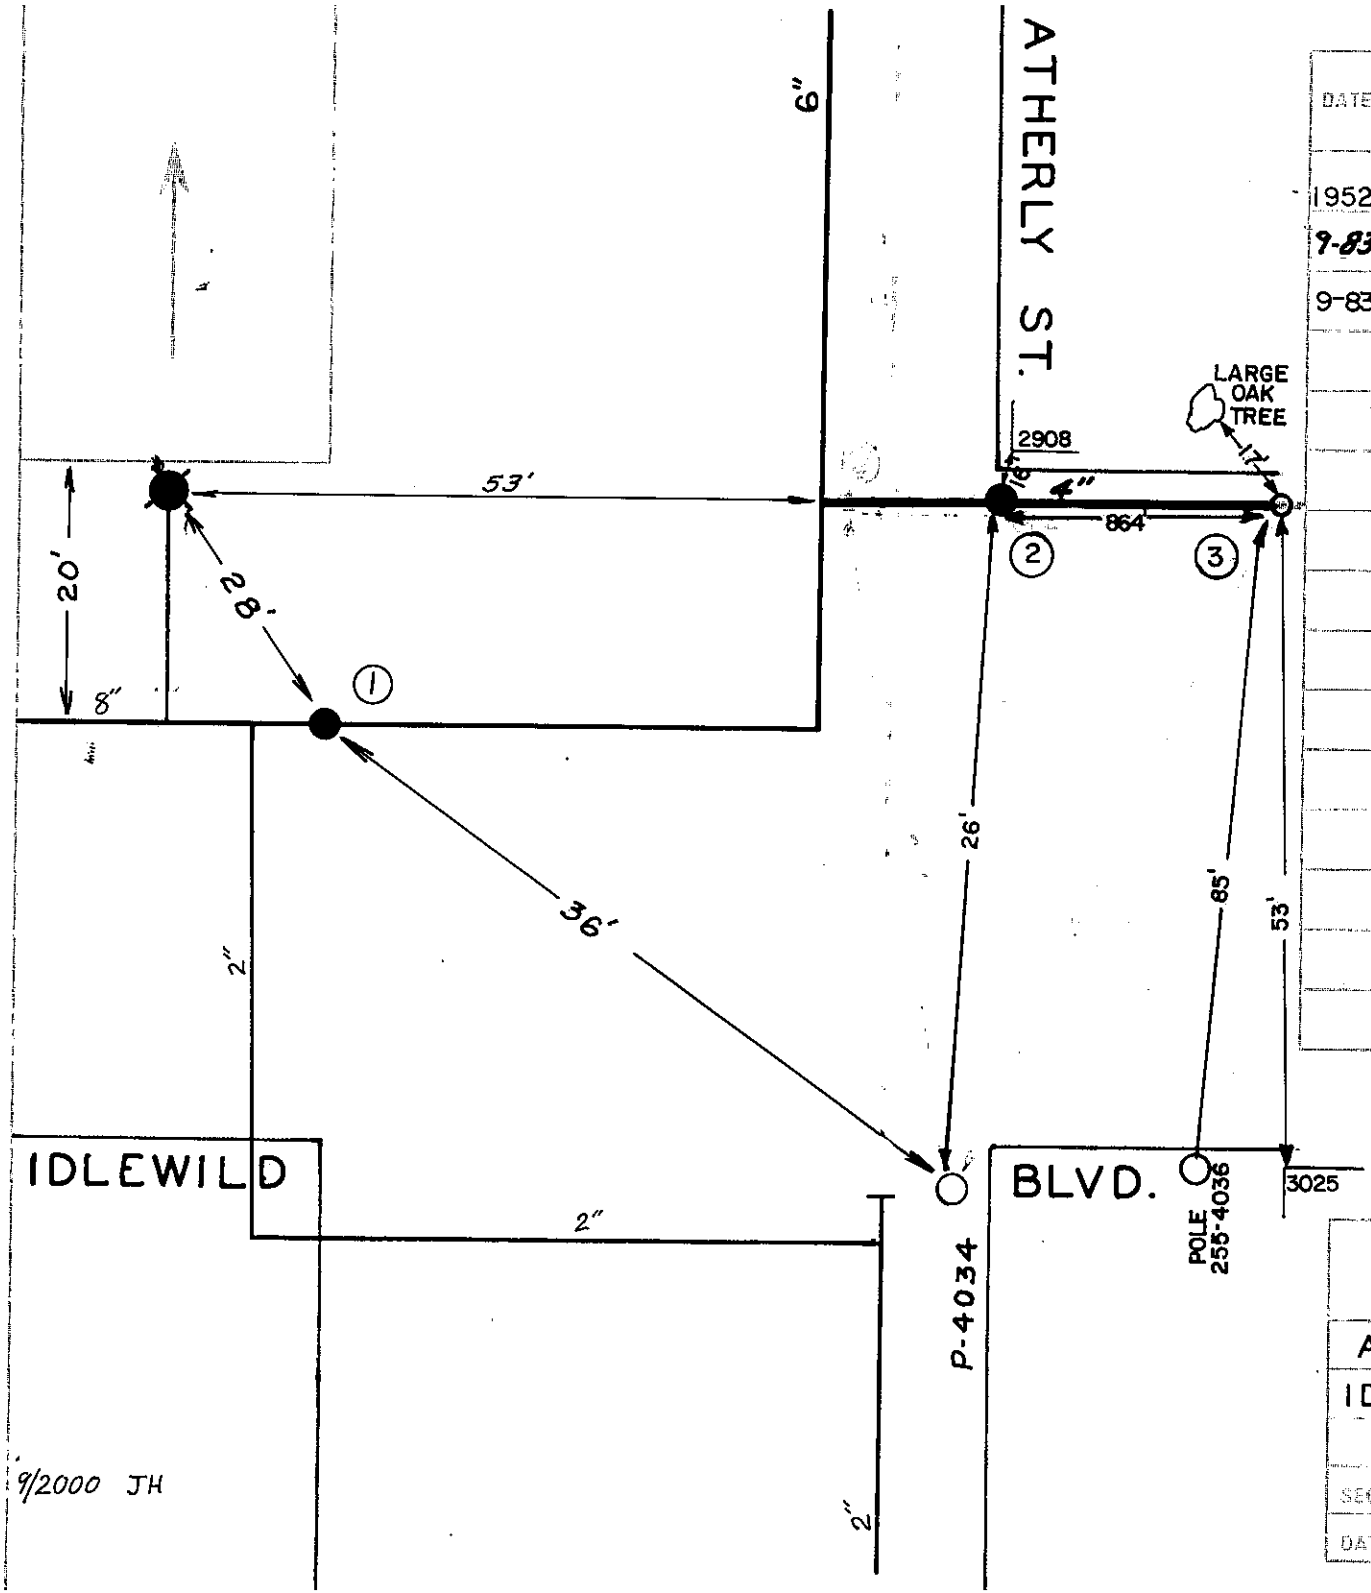


| DATE | NO | SIZE | MAKE | OPEN | TURNS |
|---|---|---|---|---|---|
| 1952 | 1 | 8" | | R | |
| 9-83 | 2 | 4" | DARL. | R | 15 |
| 9-83 | 3 | 2" | MISC. | L | |
| | 1 | 0 | WPL | | |

CITY OF ROANOKE — WATER DEPT

VALVE DIAGRAM

ATHERLY ST. &

IDLEWILD BLVD.

SEC MAP 341, 704 N.E.

DATE PAGE NO