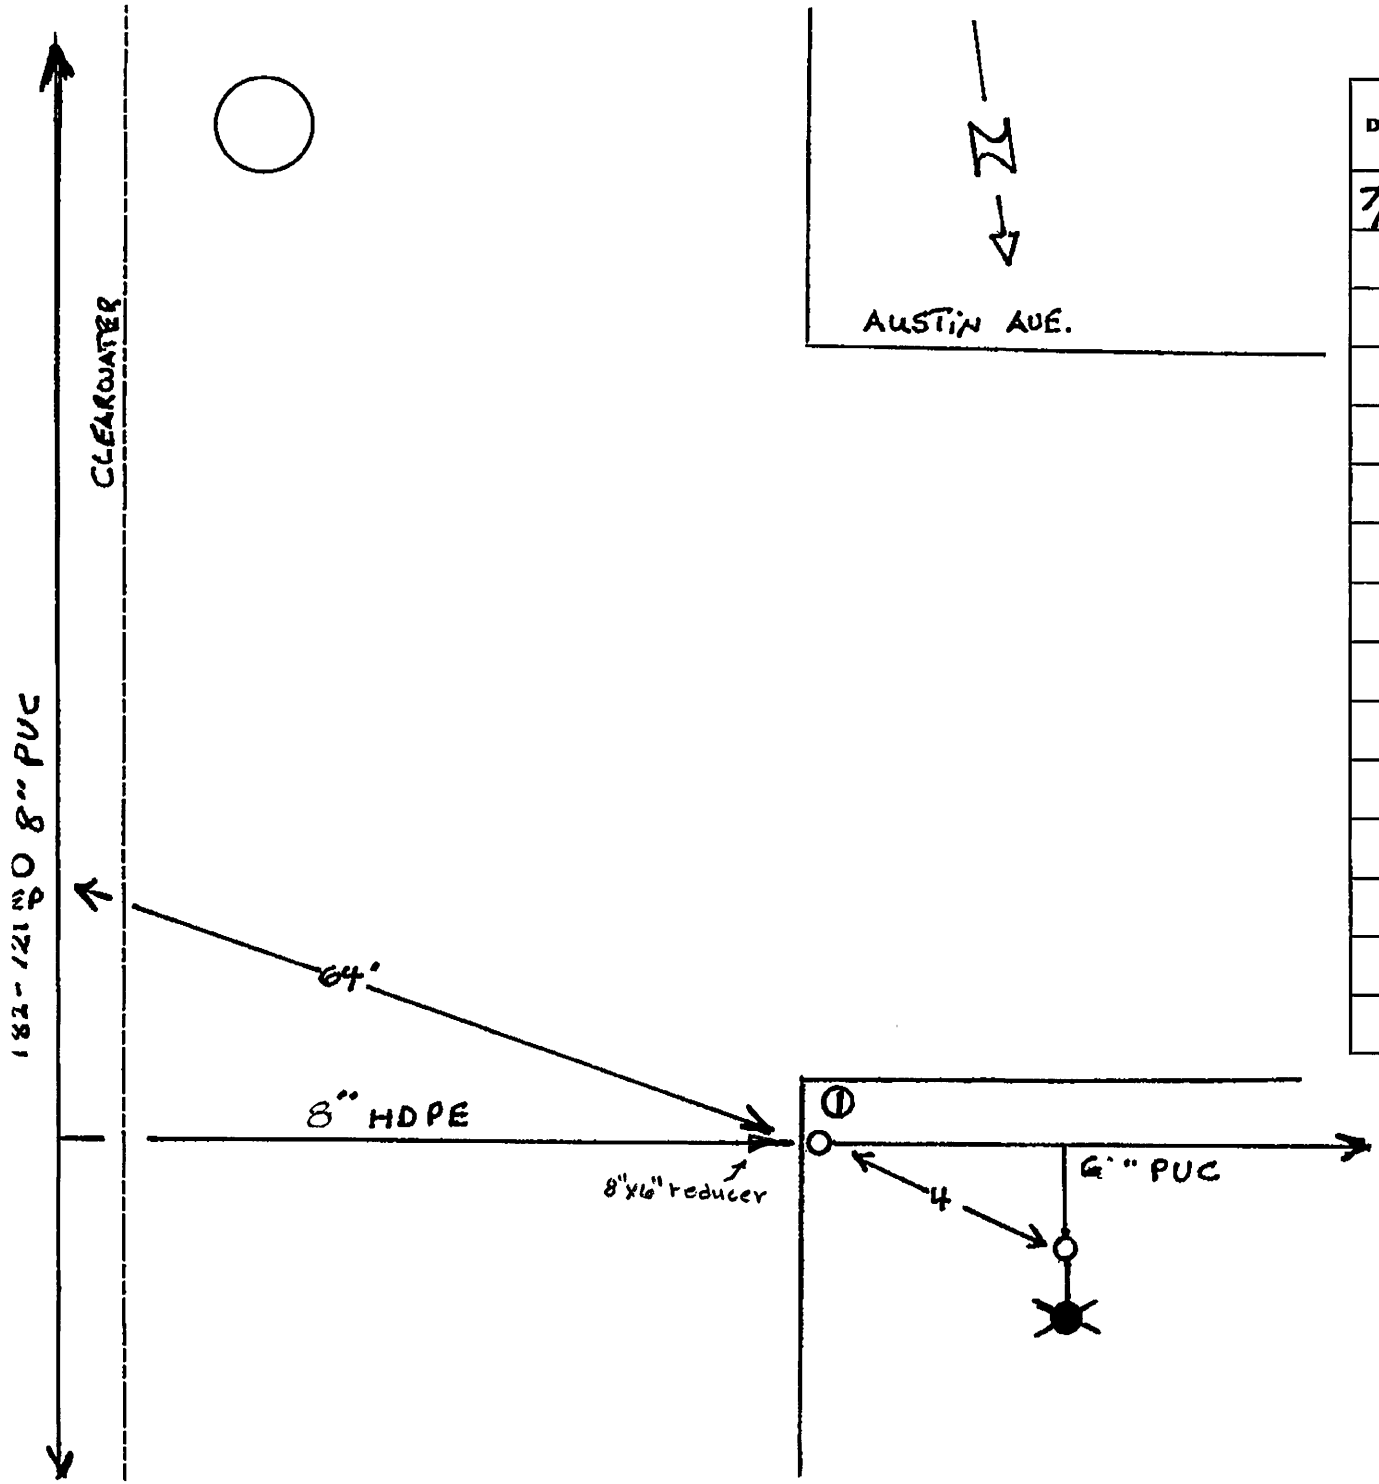

DATE	NO.	SIZE	MAKE	OPEN	TURNS
7/08	1	6"	KENNEDY	L	27

WESTERN VIRGINIA WATER AUTHORITY

VALVE DIAGRAM

AUSTIN AVE AND CLEARWATER AVE. NE.

SECT. MAP

DATE 8-1-08