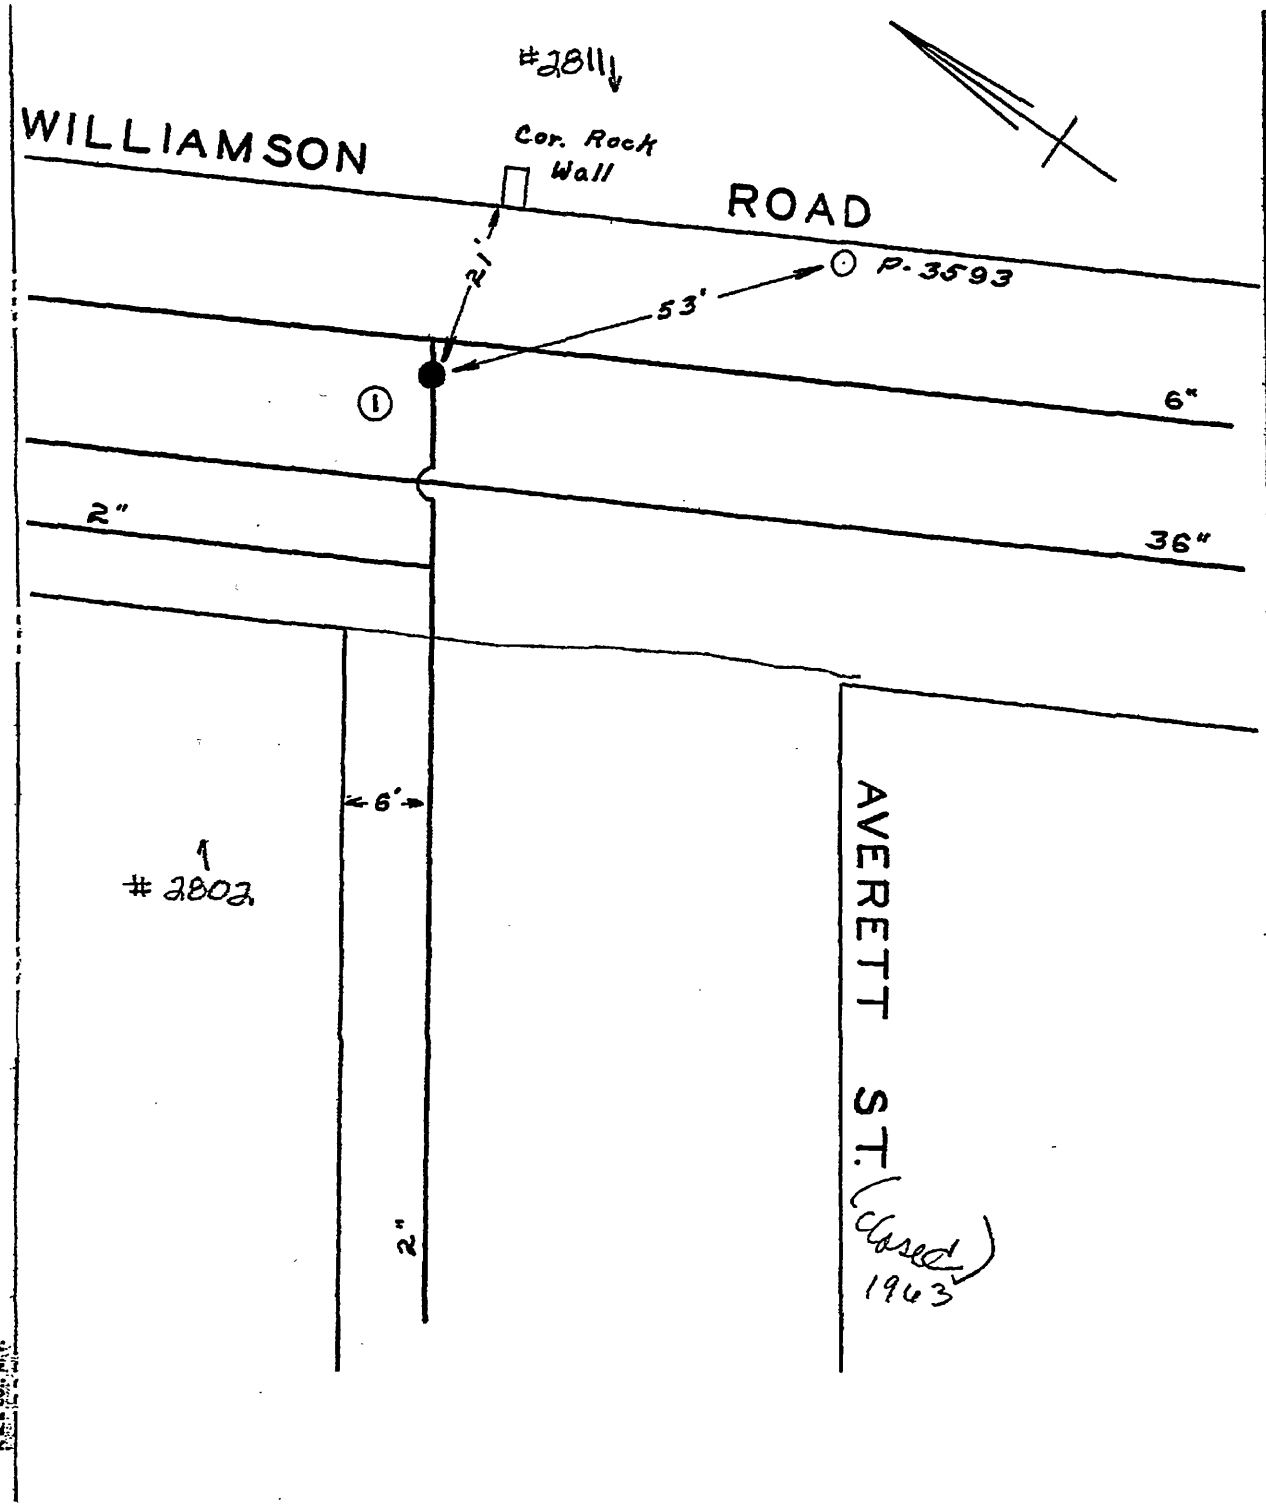

DATE	NO.	SIZE	MAKE	OPEN	TURNS
1951 W.R	1	2"			
	1	16-W	EPL		

CITY OF ROANOKE—WATER DEPT.

VALVE DIAGRAM

AVERETT ST. (CLOSED) & WILLIAMSON ROAD N.W. OR N.E.

SEC. MAP 207 — 3 10

DATE PAGE NO.

IMPERIAL TRACING CLOTH